





SCALES:
 1" = 50' HOR
 1" = 5' VER

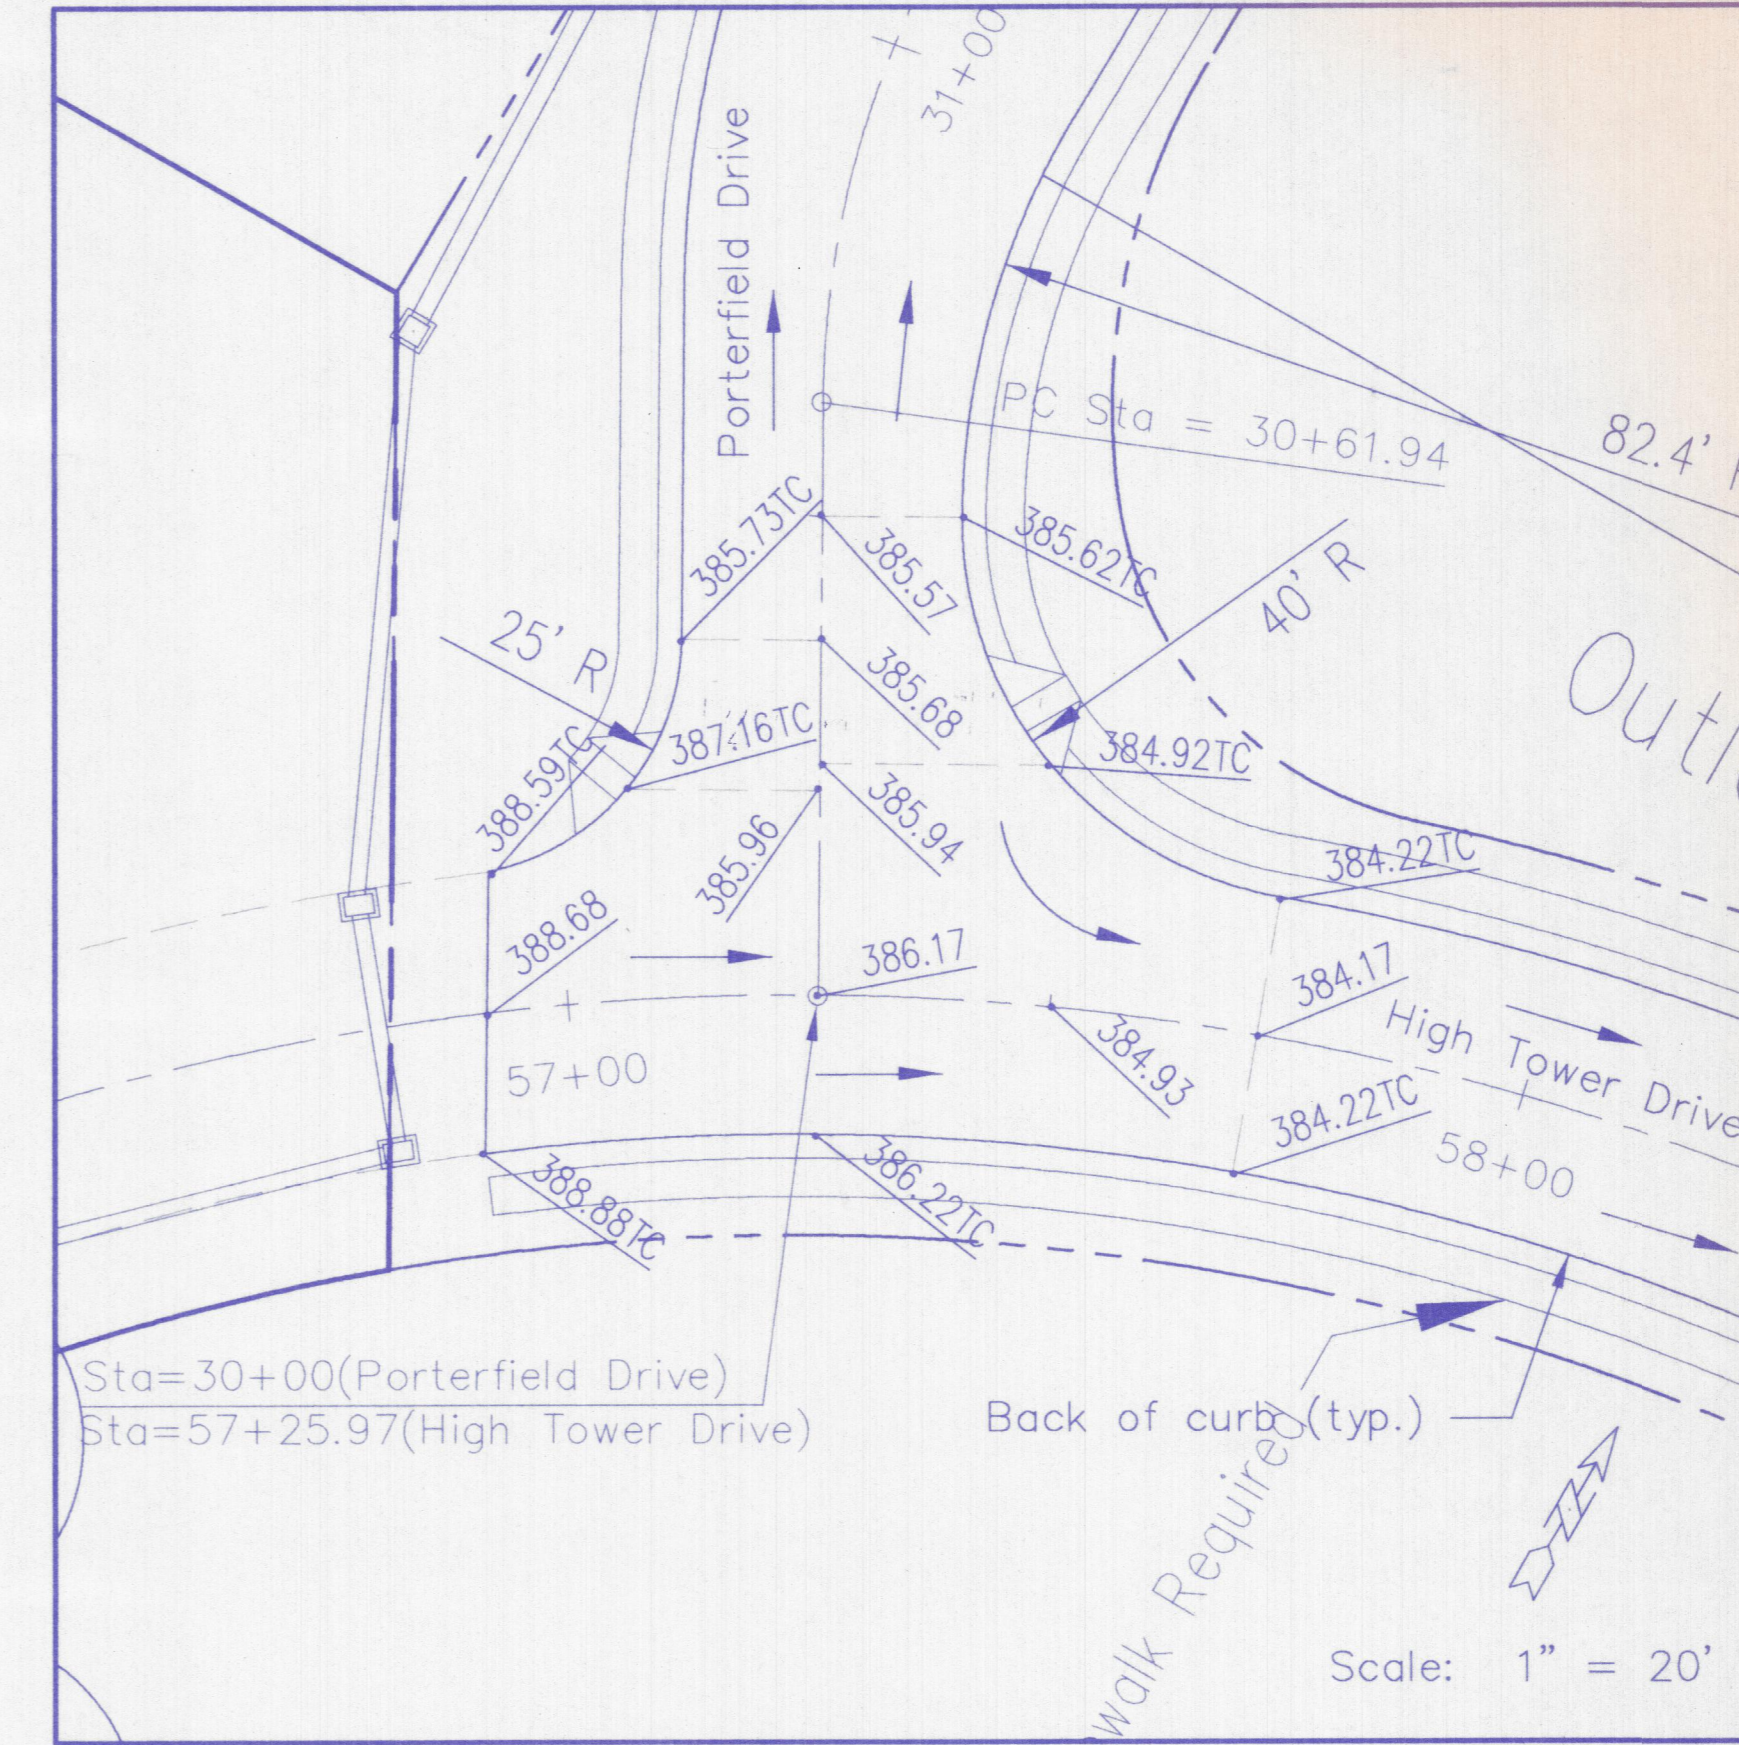

Porterfield Dr. - High Tower Dr. Intersection

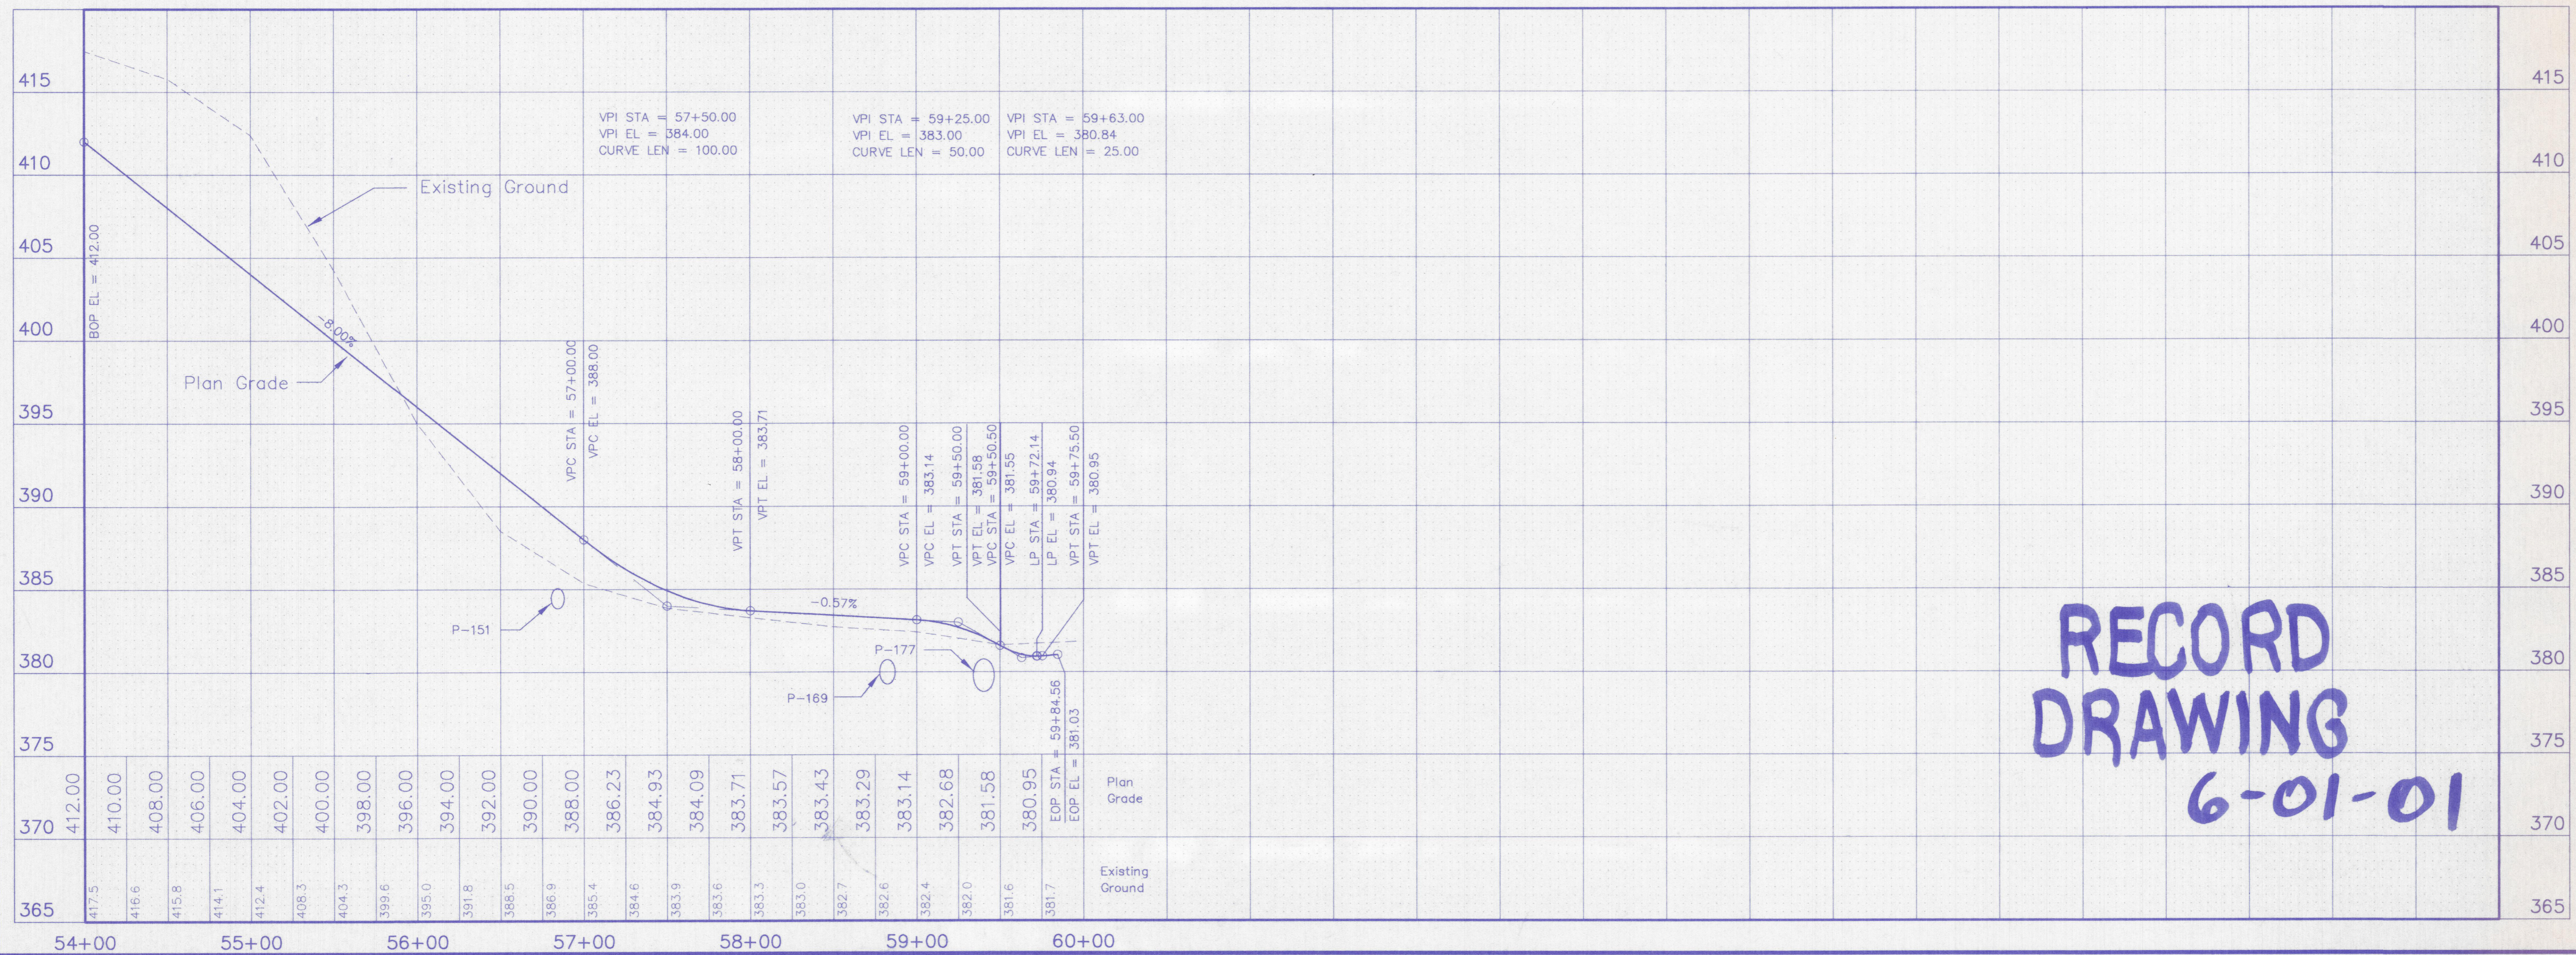


**RECORD
DRAWING**
6-01-01

Morley and Associates,
 Consulting Engineers/Surveyors/Architects
 600 S.E. Sixth Street
 Evansville, Indiana 47713
 (812) 464-9585



No.	By	Date	Description

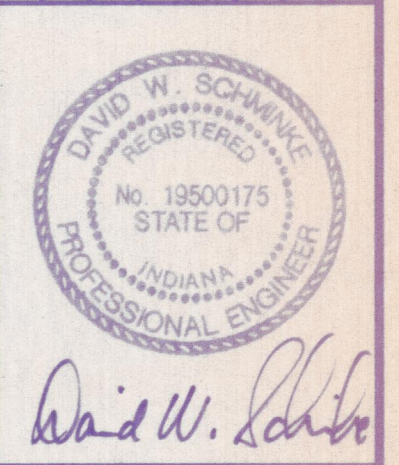

Project: Keystone Section VII
 Keystone Development, LLC
 Sheet Title: High Tower Drive
 Plan and Profile
 Scale: As Shown
 Designed By: DWS Job Number: 3998-4
 Drawn By: GAM Date: 9-19-00
 Checked By: RCP Date: 9-19-00
 Sheet Number: C-7 of 18