


SURVEYED BY: _____ DATE: _____
 PLAN
 NOTE BOOK NO. _____
 PLANNED BY: _____
 ADJUSTMENT CHECKED BY: _____
 RT. OF WAY CHECKED BY: _____
 No. _____

SURVEYED BY: _____ DATE: _____
 PROFILE
 NOTE BOOK NO. _____
 PLANNED BY: _____
 ADJUSTMENT CHECKED BY: _____
 E. M. S. NOTED BY: _____
 STRUCTURE NOTATIONS CHECKED BY: _____
 No. _____

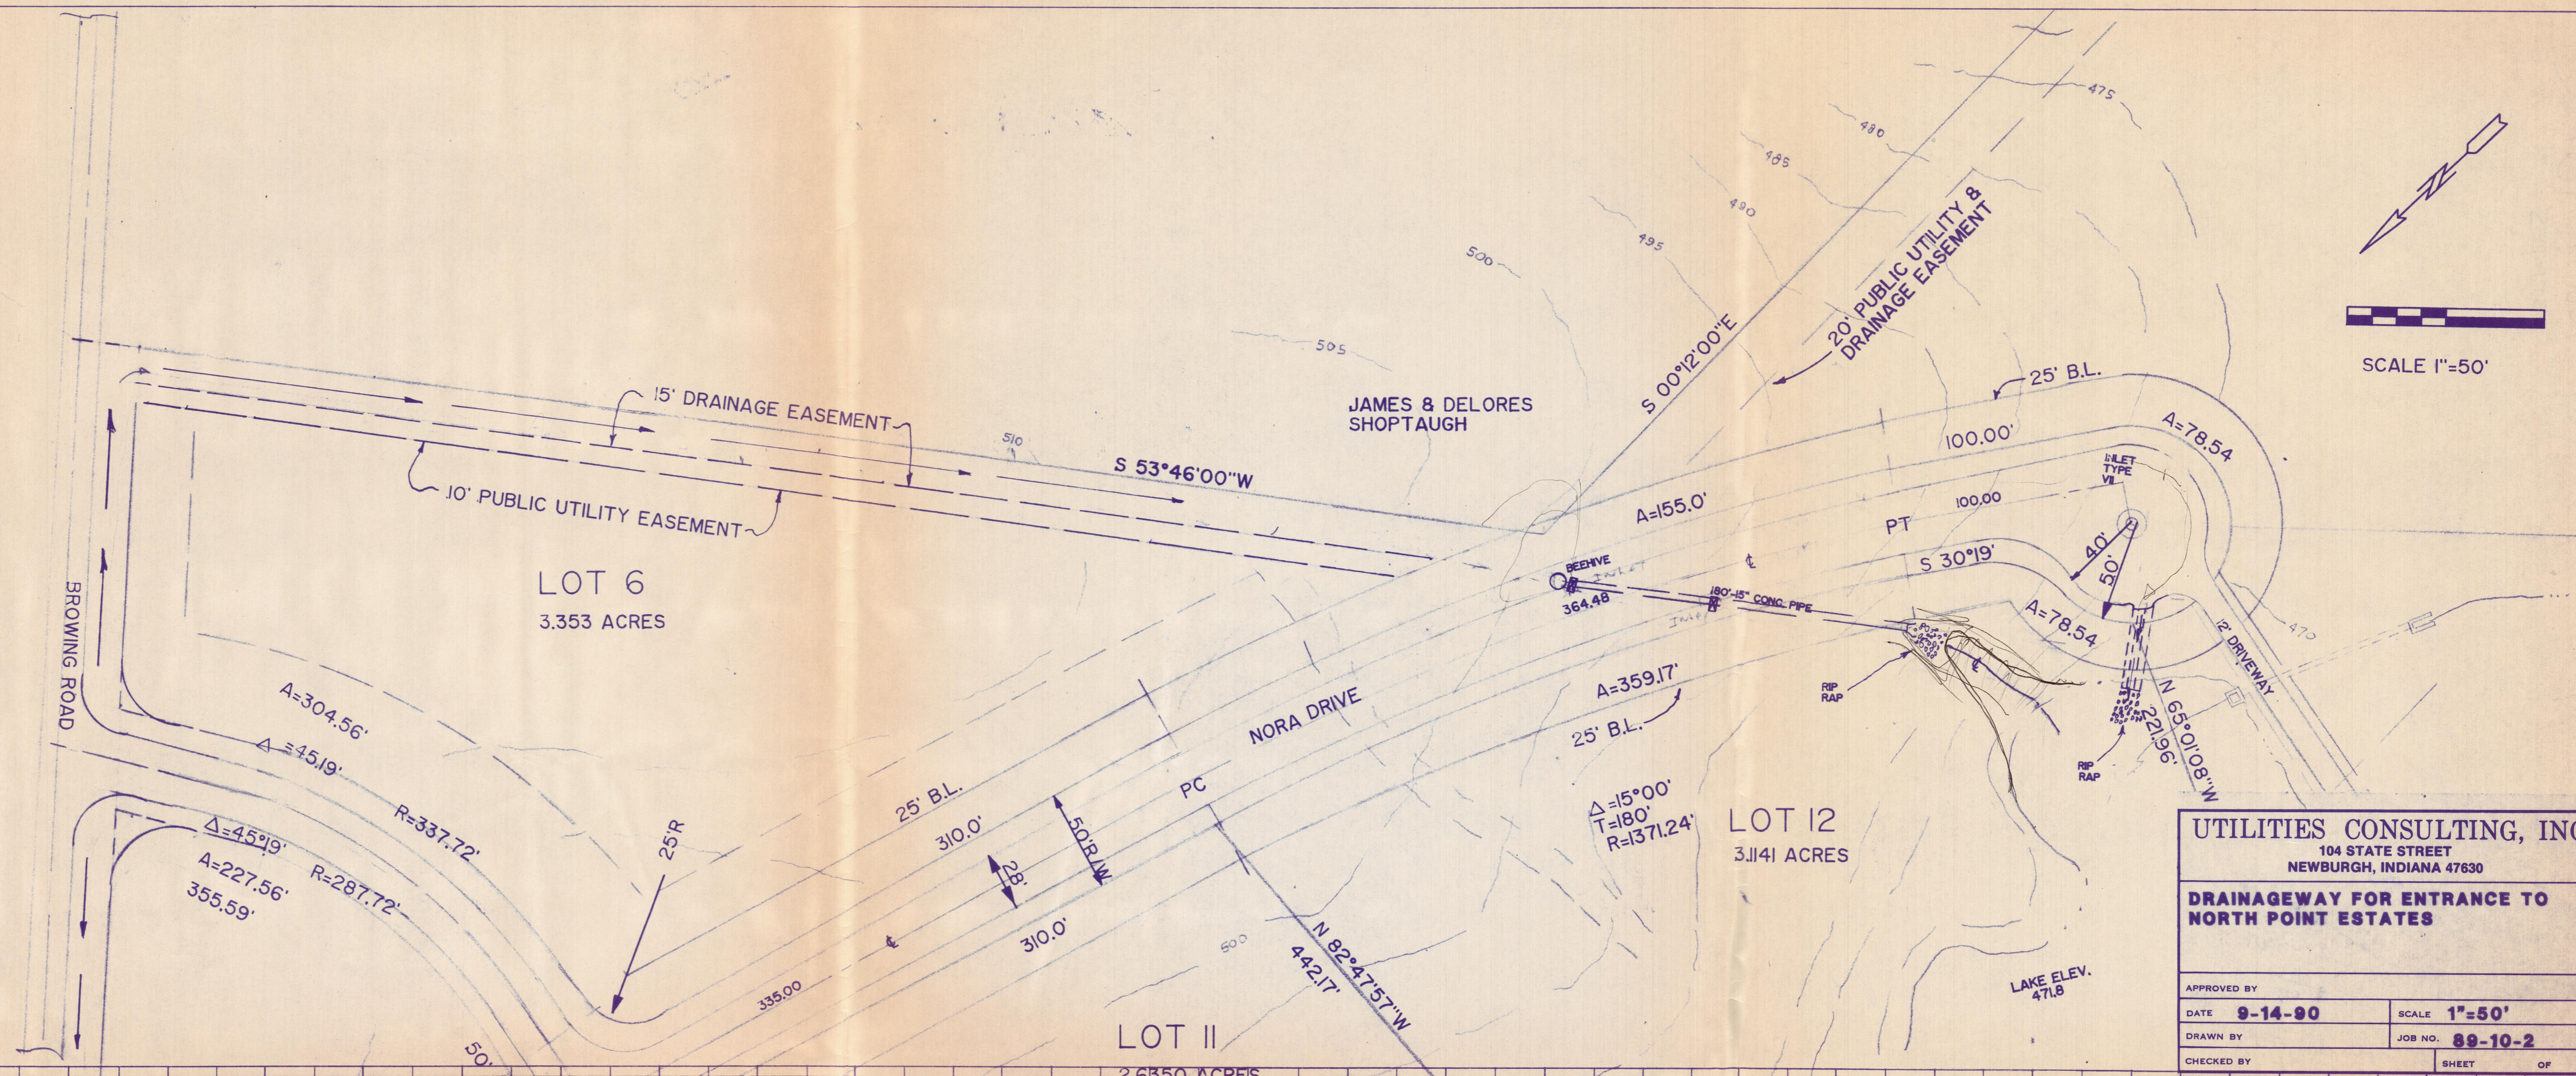

UTILITIES CONSULTING, INC.
 104 STATE STREET
 NEWBURGH, INDIANA 47630

**DRAINAGEWAY FOR ENTRANCE TO
 NORTH POINT ESTATES**

APPROVED BY	SCALE	1"=50'
DATE	9-14-90	JOB NO.
DRAWN BY		89-10-2
CHECKED BY		SHEET
		OF