


PLAN	BY		DATE	
	SURVEYED	ALIGNED	CHECKED	RT. OF WAY

PROFILE	BY		DATE	
	SURVEYED	GRADES	CHECKED	STRUCTURE


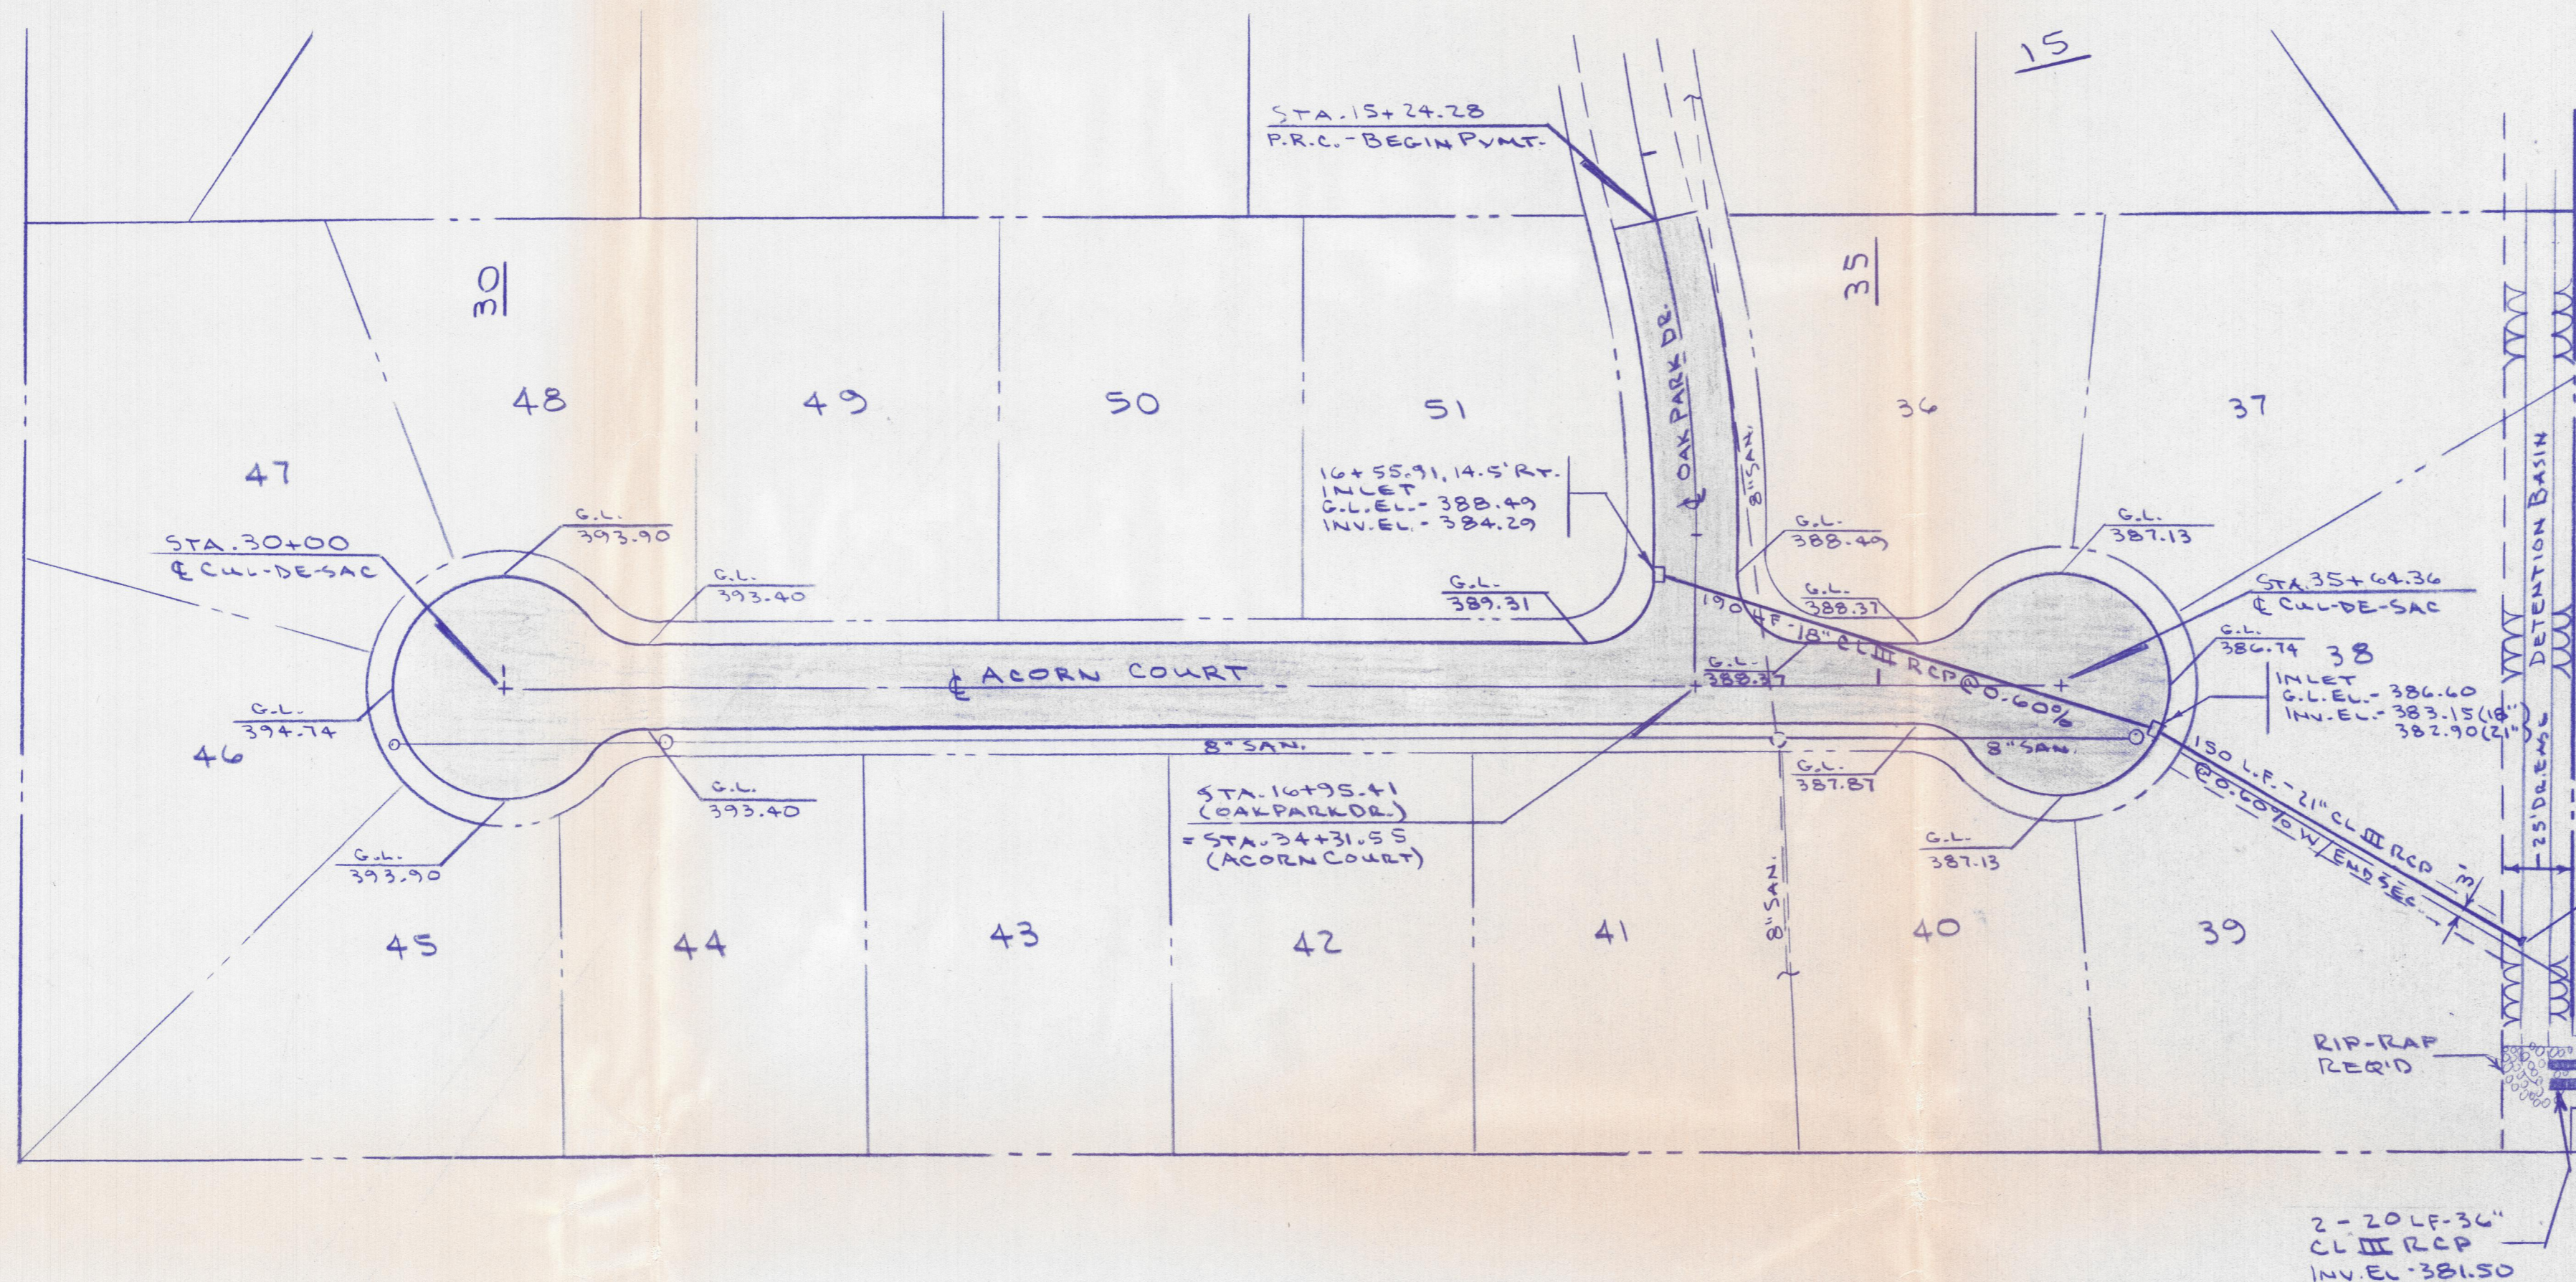


ROADWAY PLANS  
 APPROVED BY BOARD OF COUNTY COMMISSIONERS  
 VANDERBURGH COUNTY, INDIANA  
 BY: Robert D. Willman DATE 7/3/89  
 PRESIDENT  
 BY: \_\_\_\_\_ DATE \_\_\_\_\_  
 V. PRESIDENT  
 BY: Carolyn McClintock DATE 7/3/89  
 MEMBER  
 ATTEST BY: Don Humphreys DATE 7-3-89

RECOMMENDED FOR APPROVAL  
 BY: Henry White DATE 7/3/89  
 COUNTY HIGHWAY ENGINEER

DRAINAGE PLANS  
 APPROVED BY VANDERBURGH COUNTY DRAINAGE BOARD  
 VANDERBURGH COUNTY, INDIANA  
 BY: \_\_\_\_\_ DATE \_\_\_\_\_  
 PRESIDENT  
 BY: Robert D. Willman DATE 7-3-89  
 V. PRESIDENT  
 BY: Carolyn McClintock DATE 7/3/89  
 MEMBER  
 ATTEST BY: Don Humphreys DATE 7-3-89

RECOMMENDED FOR APPROVAL  
 BY: \_\_\_\_\_ DATE \_\_\_\_\_  
 COUNTY SURVEYOR

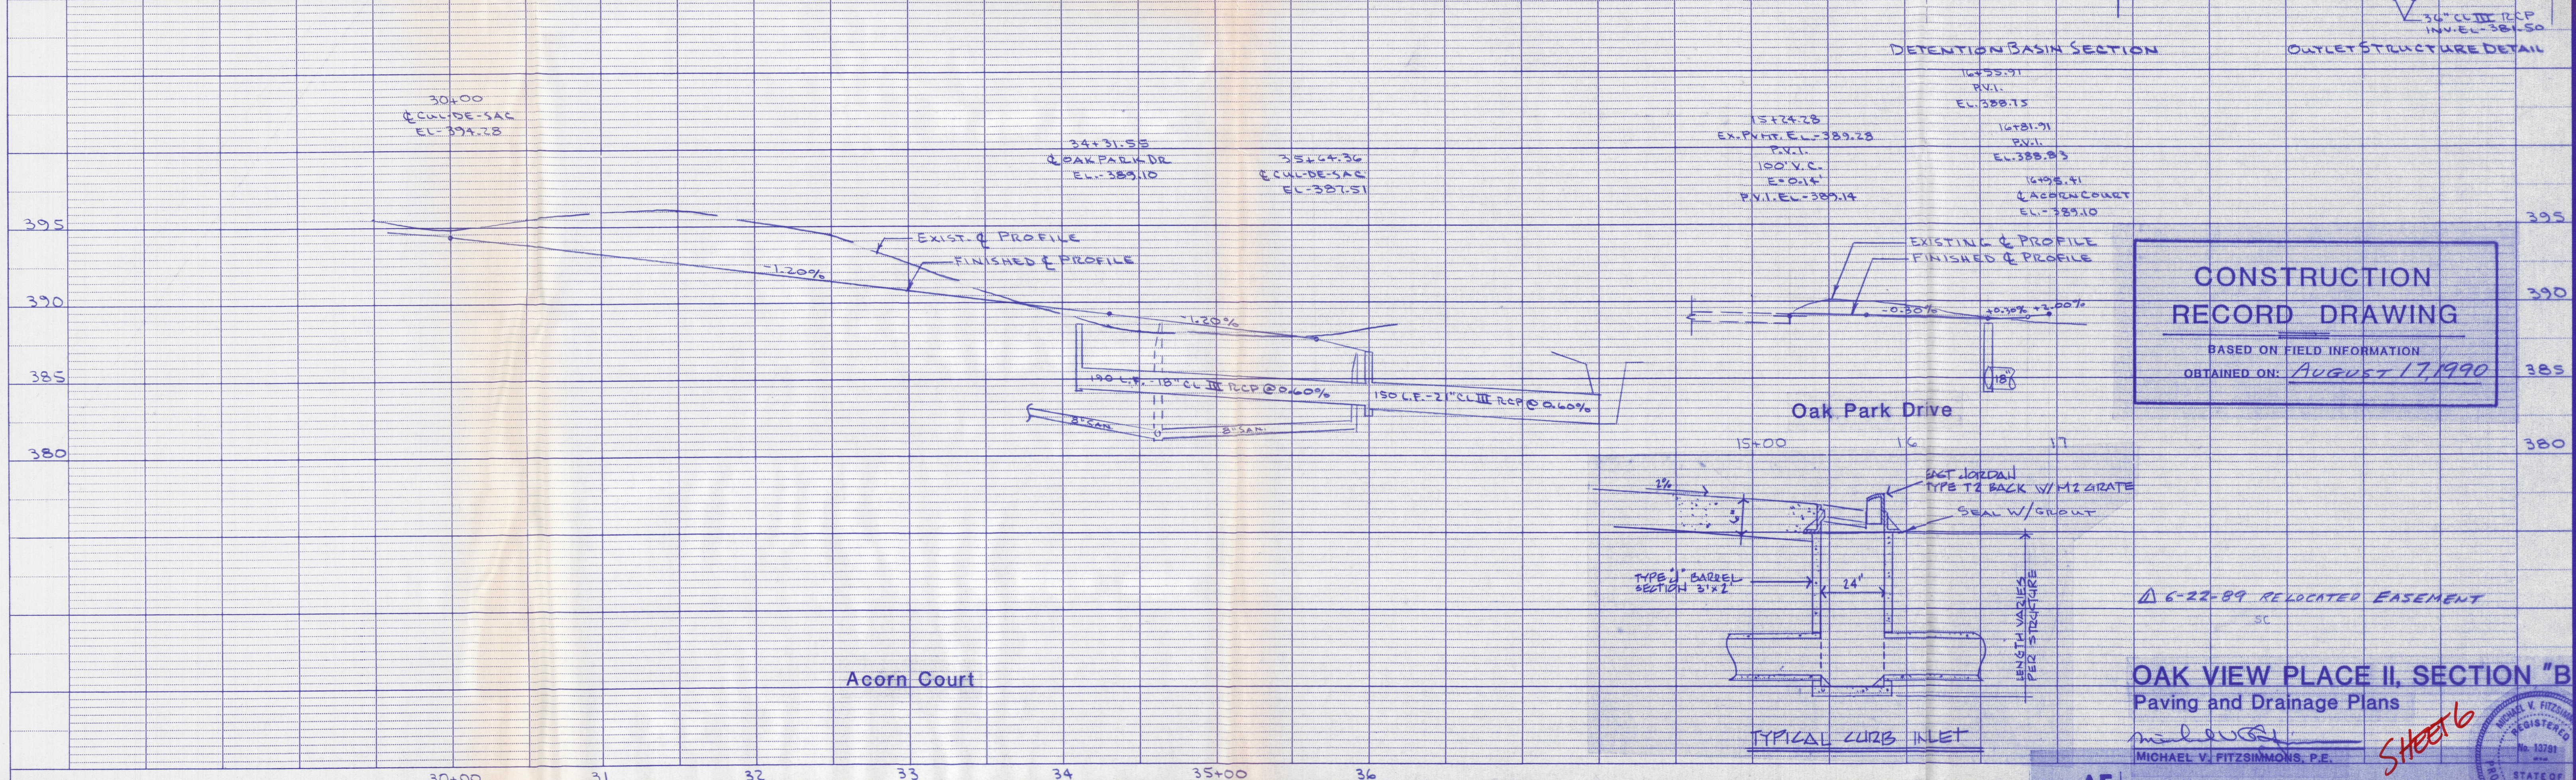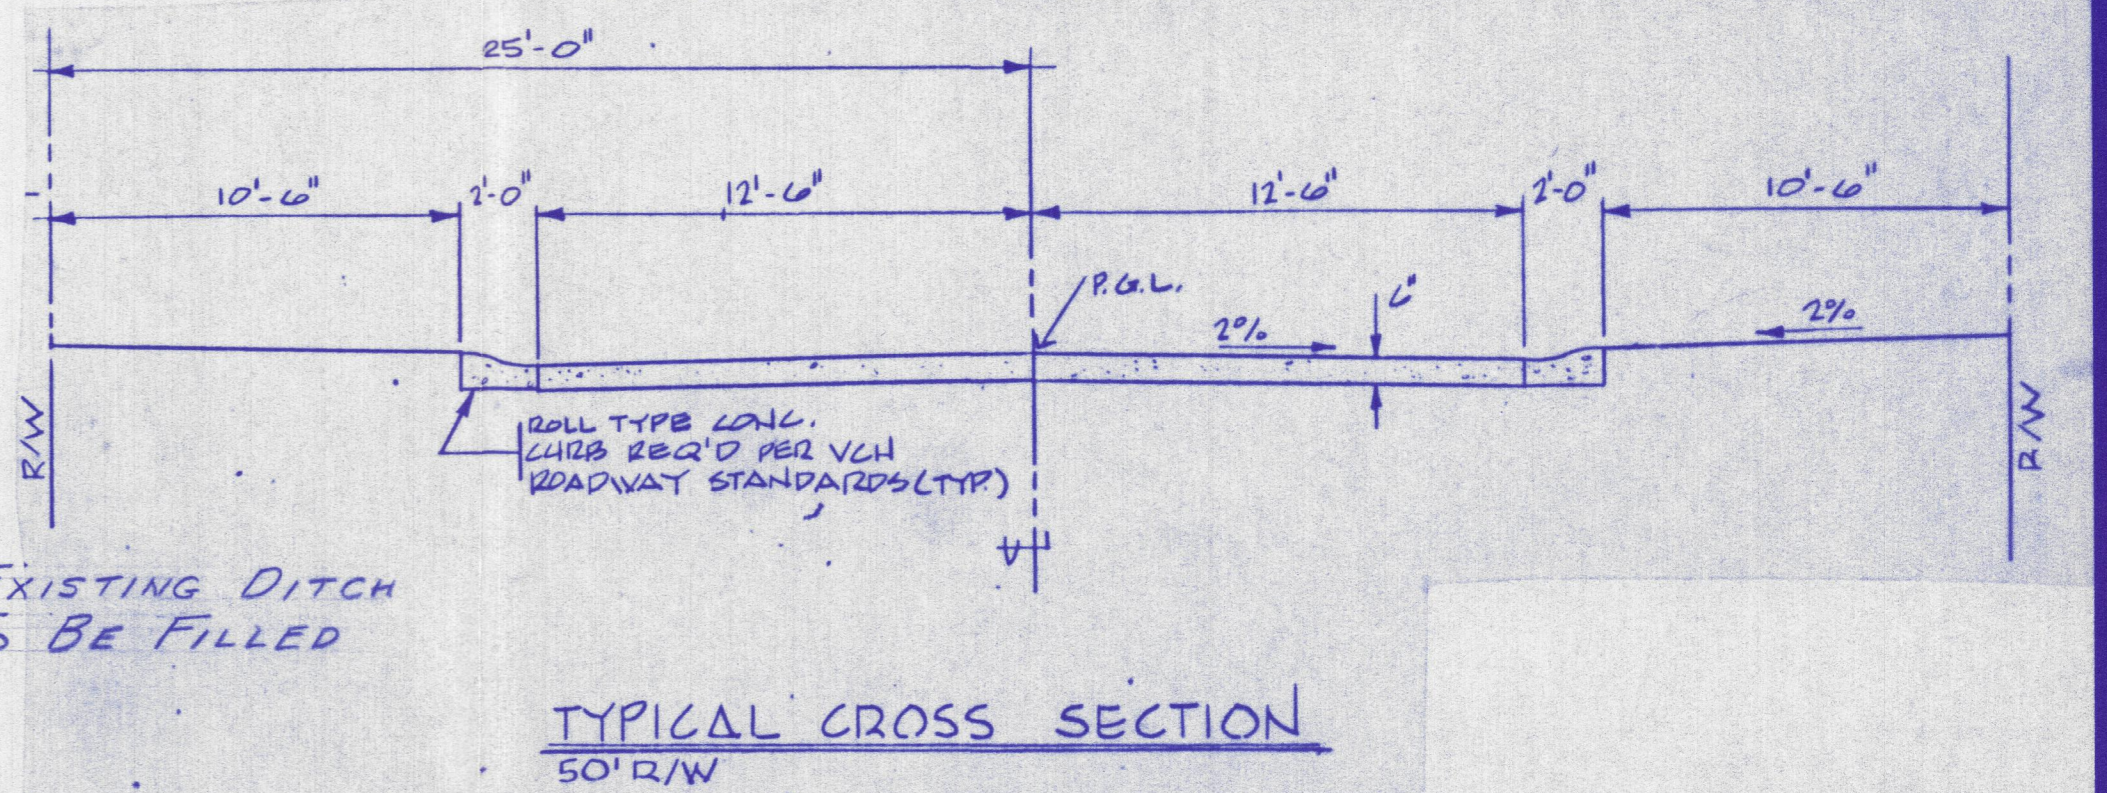

**CONSTRUCTION RECORD DRAWING**  
 BASED ON FIELD INFORMATION  
 OBTAINED ON: AUGUST 17, 1990

6-22-89 RELOCATED EASEMENT  
 OAK VIEW PLACE II, SECTION "B"  
 Paving and Drainage Plans  
 MICHAEL V. FITZSIMMONS, P.E.  
 SHEET 6