


Written dimensions on these drawings shall have precedence over all other dimensions and conditions on the drawings. All dimensions and conditions must be notified of any variations from the dimensions and conditions shown by these drawings.


SITECON, Inc.
Engineers-Surveyors
600 S.E. Eighth Street Suite 2
Evansville, Indiana 47713
(812) 423-2320

Project: **OAKLYNN PARK**
Sheet Title: **STORM DETAIL SHEET**

No.	Date	By	Description


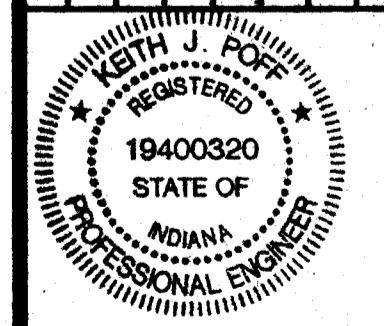


Scale: AS NOTED
Designed By: KJP Job Number: 1-94-7-1
Drawn By: JOW Date: 12-16-94
Checked By: Flenore Basms.DWG
Sheet Number: **DE-4**
of


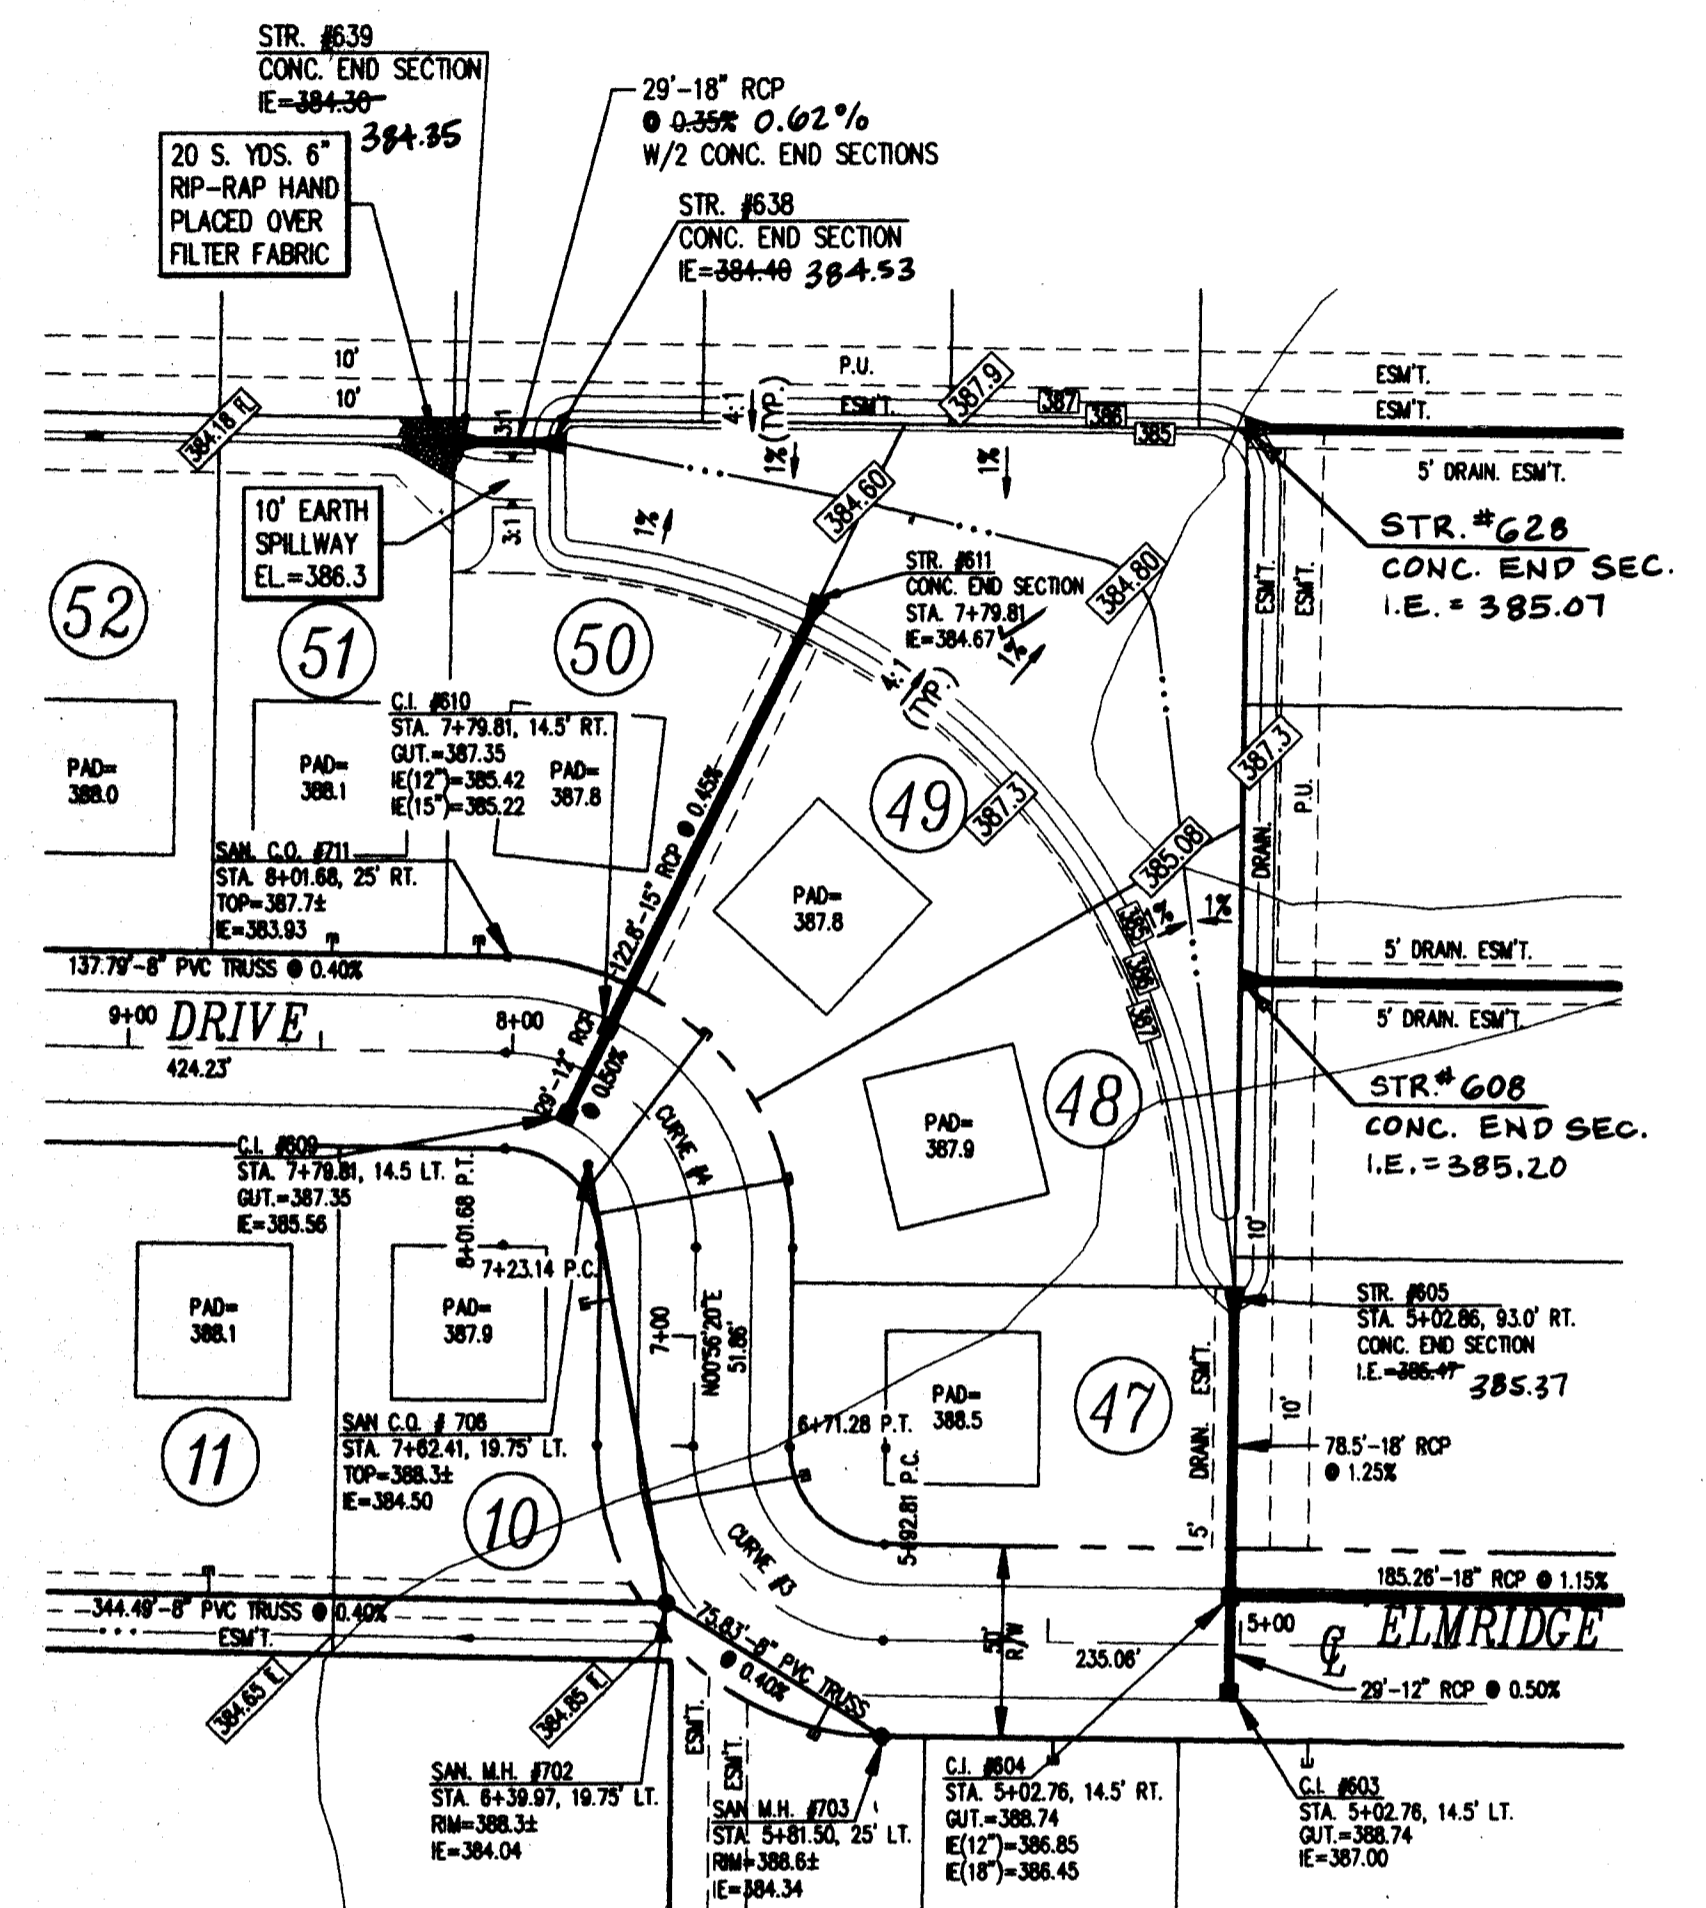


DETENTION BASIN "A" DETAIL
SECTION ONE


*Copy area
Elmer Nelson
10-16-97*

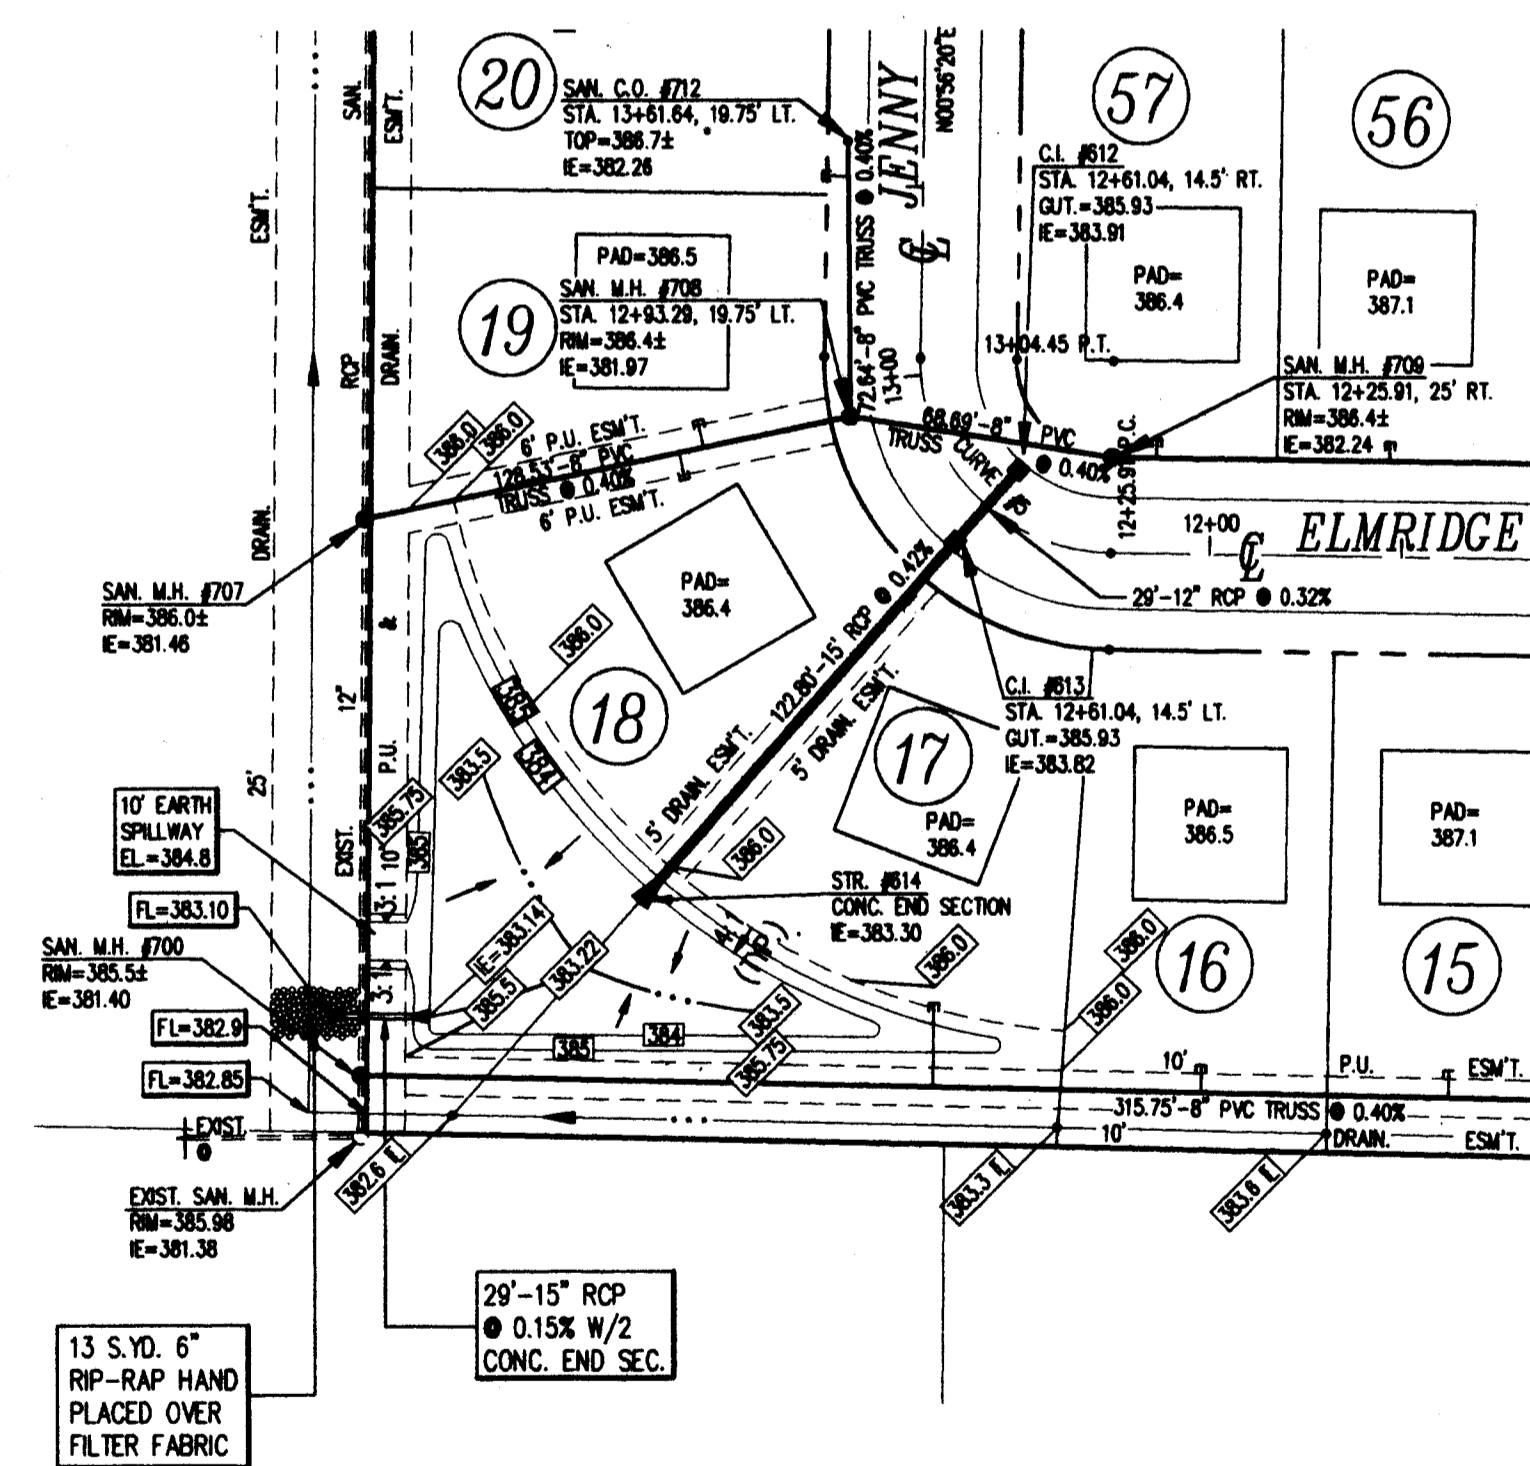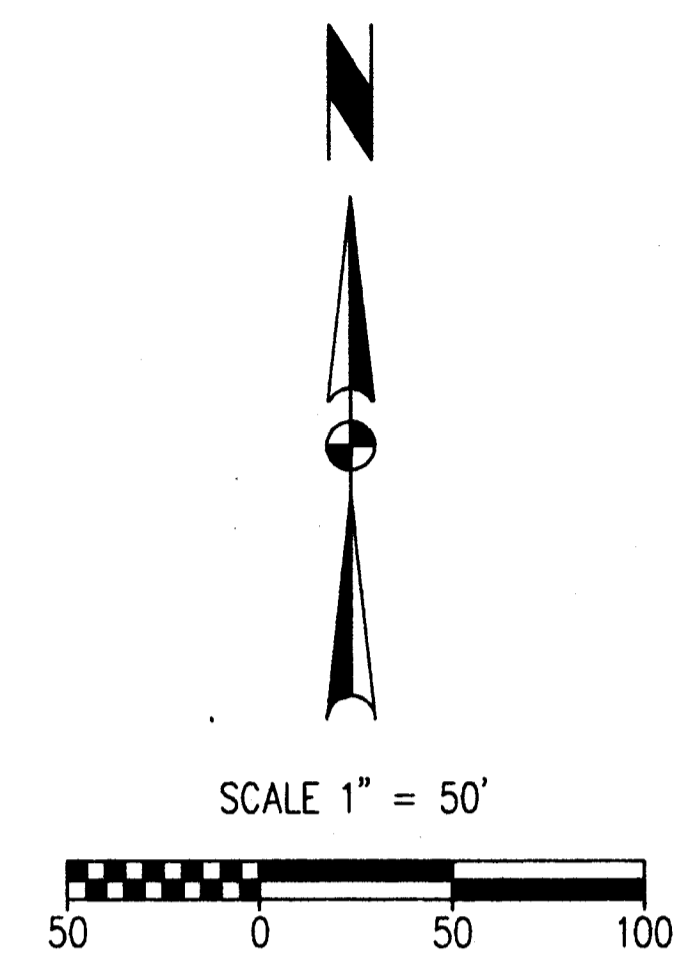

DETENTION BASIN "B" DETAIL
SECTION TWO

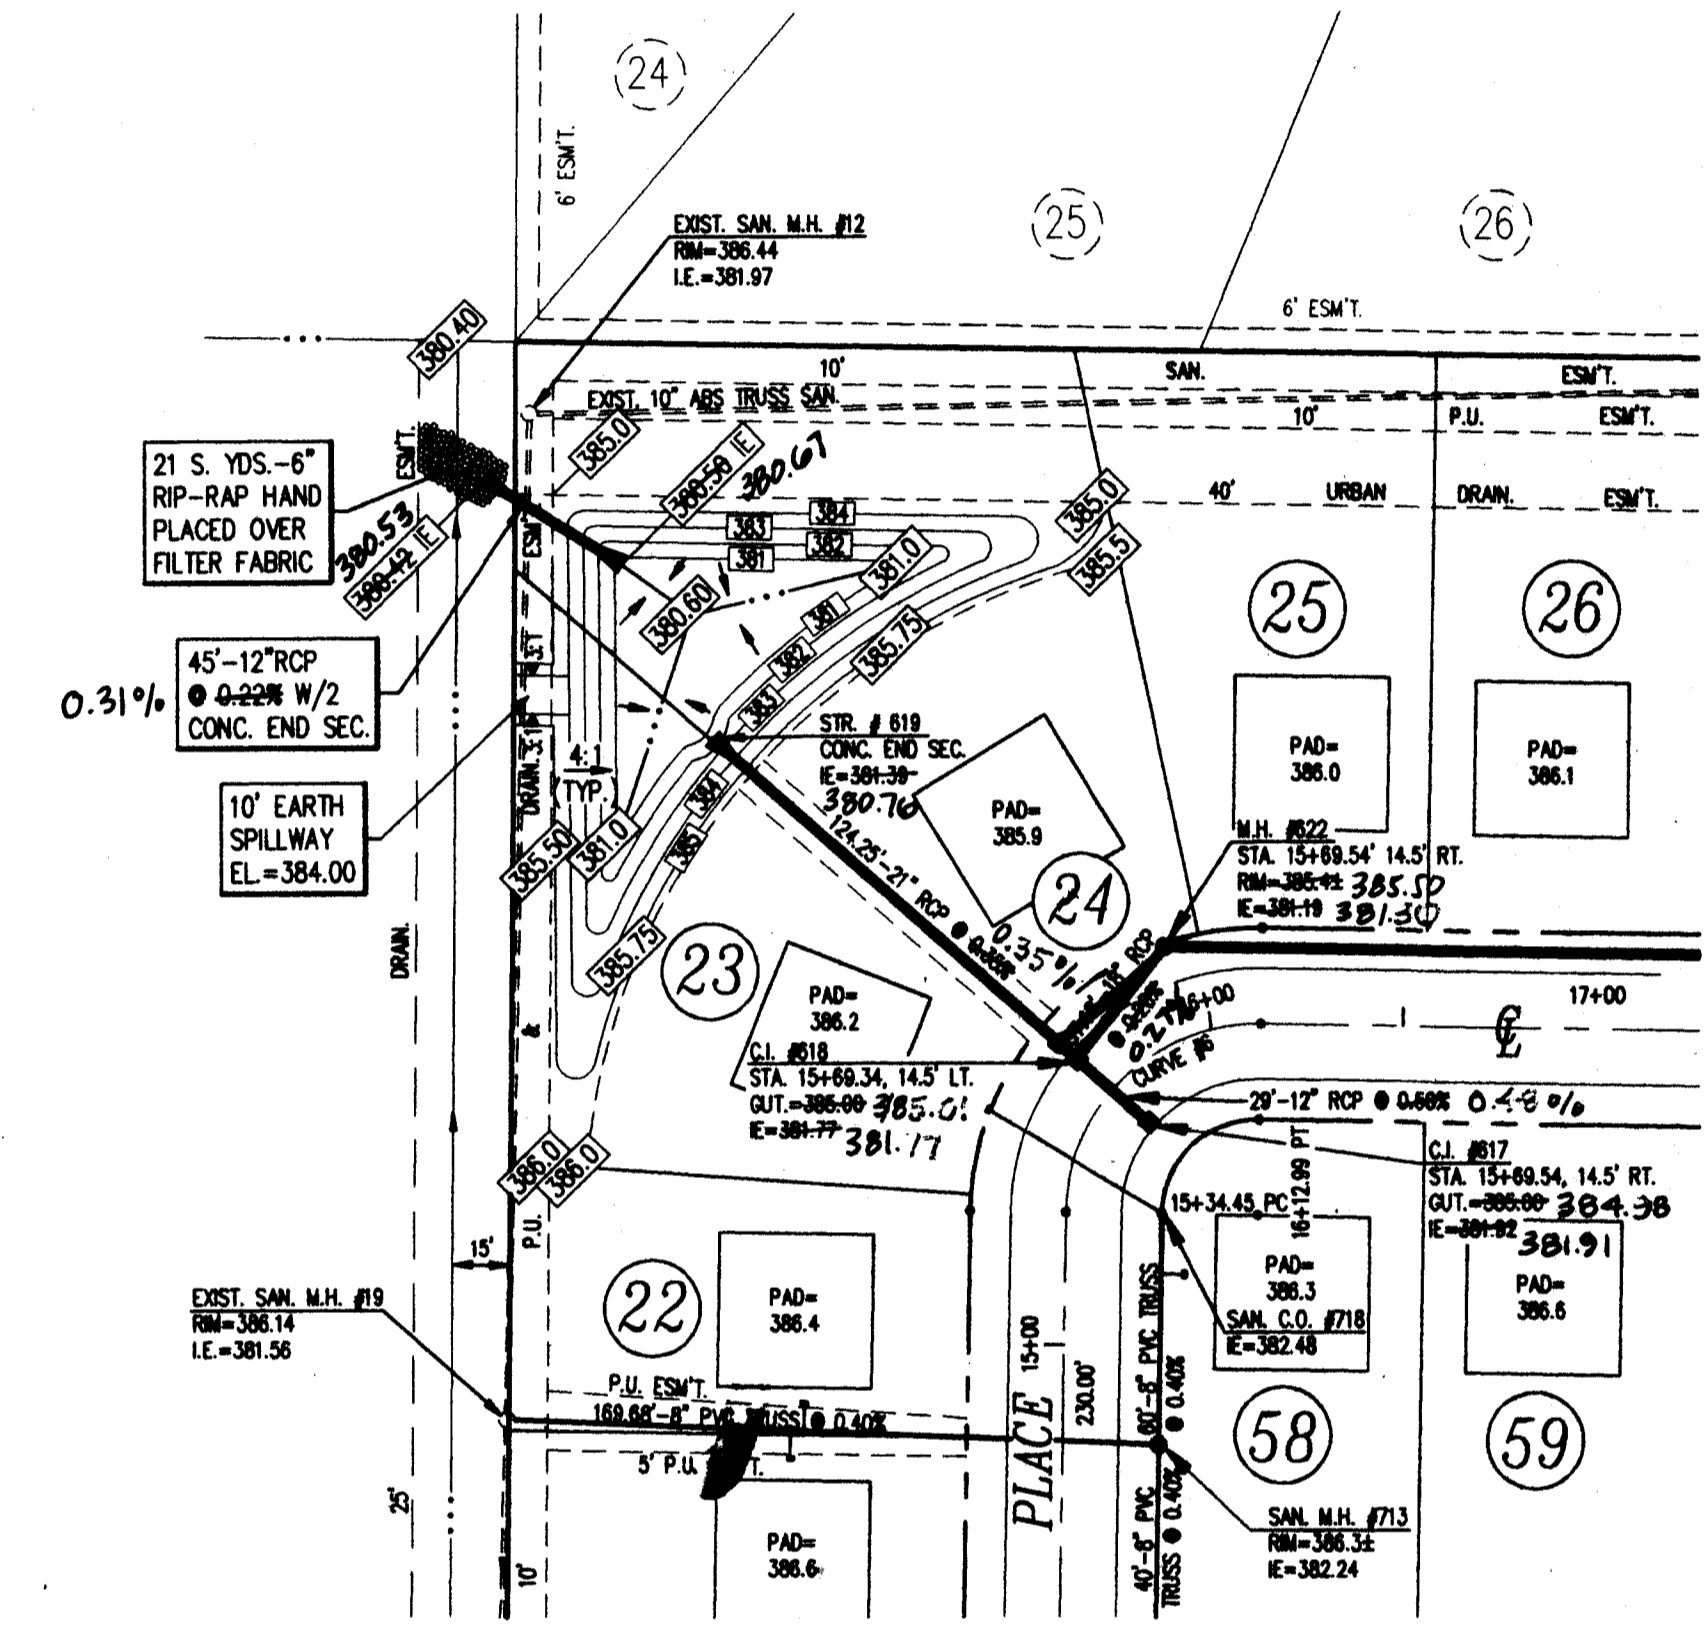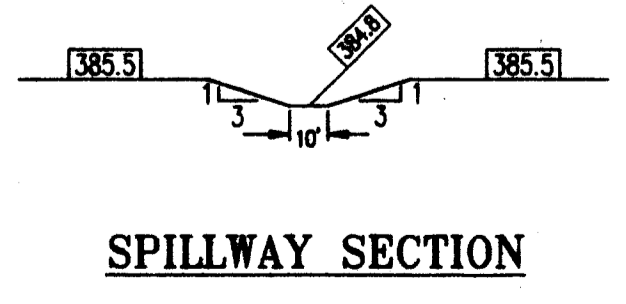

DETENTION BASIN "C" DETAIL
SECTION ONE

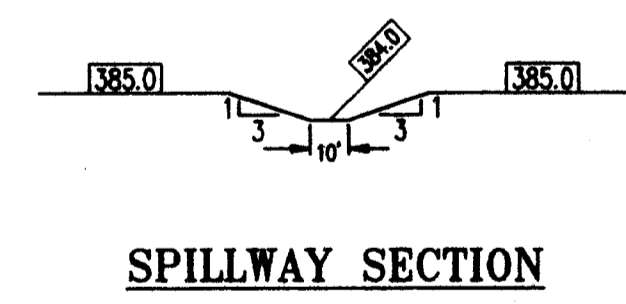

**RECORD
DRAWING**
STREET & DRAINAGE
SECTION ONE
1-26-96