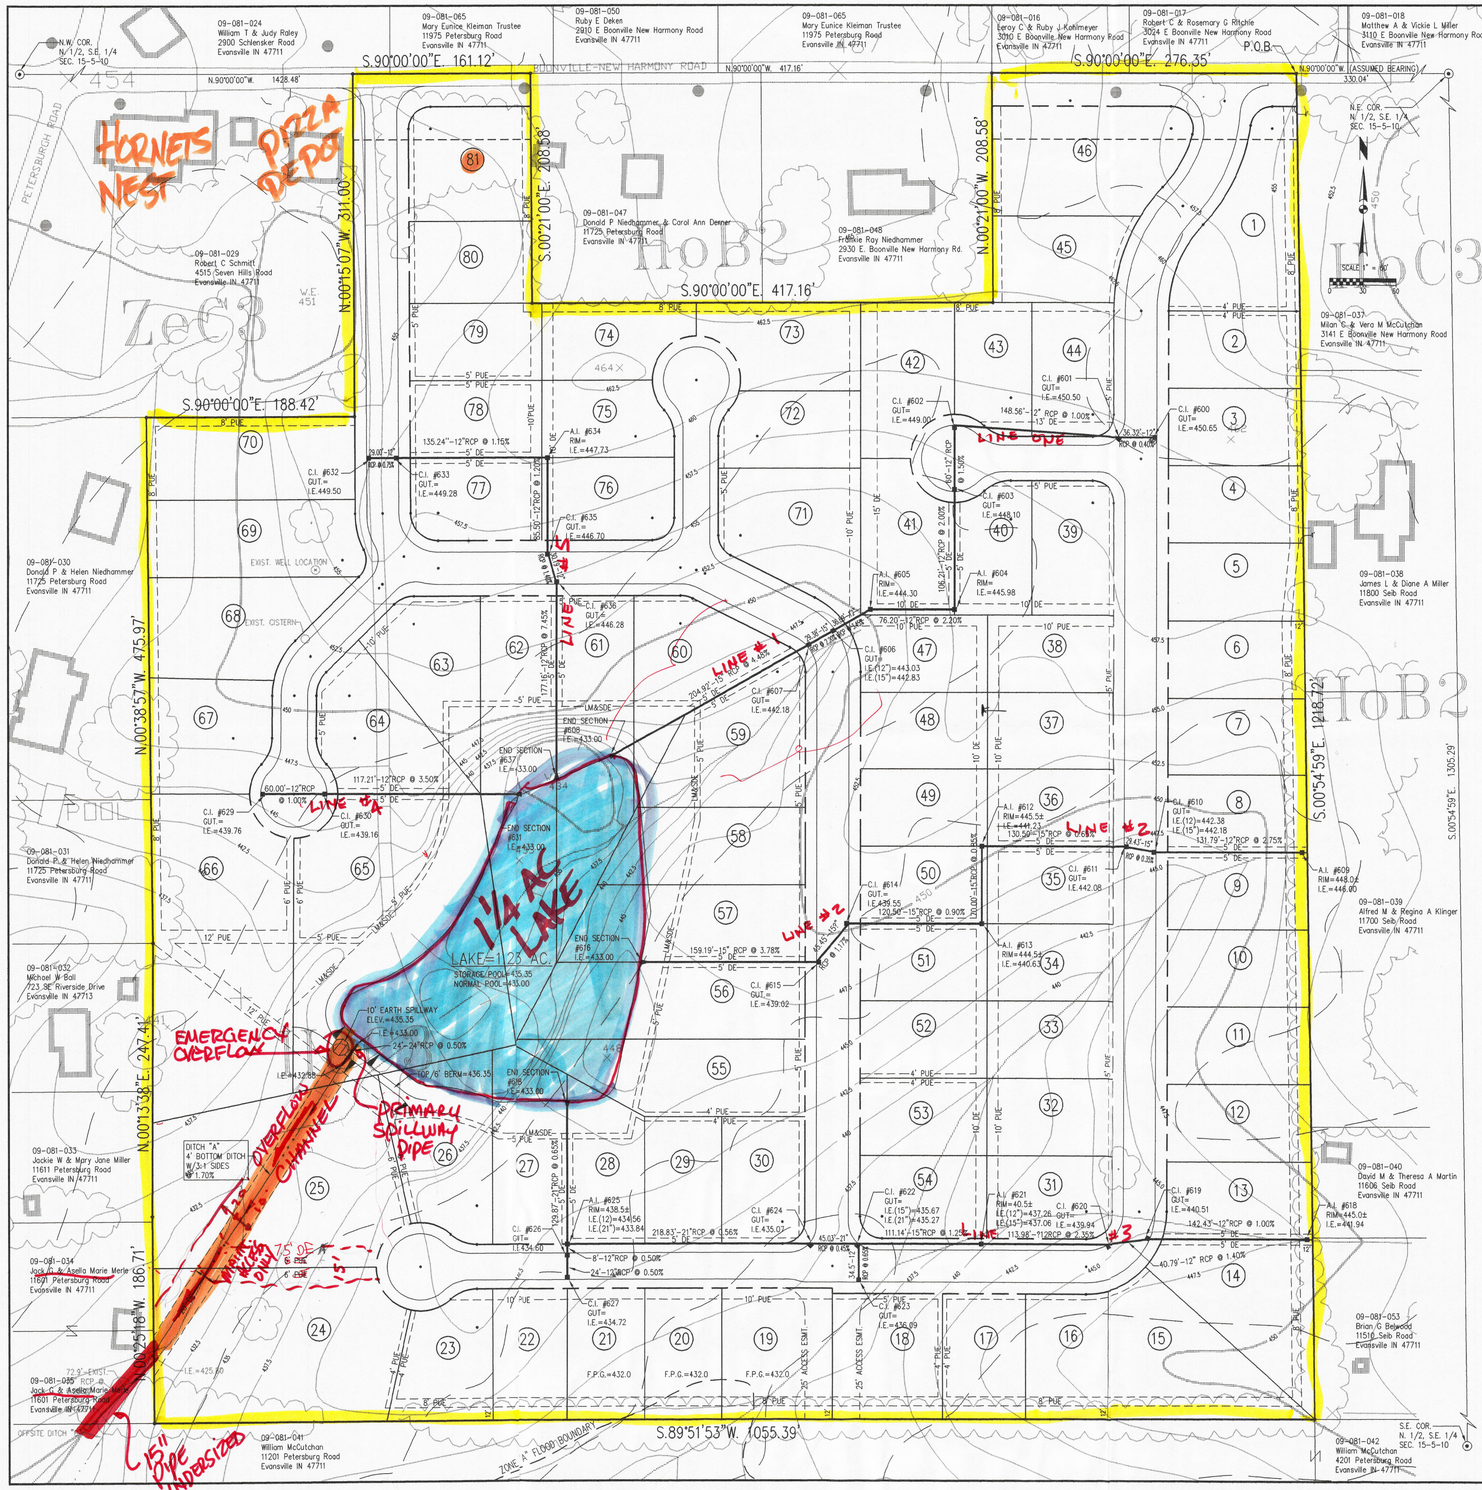


Written dimensions on these drawings shall have precedence over scaled dimensions. Contractors shall verify and be responsible for all dimensions and conditions on the job and SITECON, Inc. must be notified of any variations from the dimensions and conditions shown by these drawings.


SITECON, Inc.
Engineers-Surveyors
600 S.E. Eighth Street, Suite 2
Evansville, Indiana 47713
(812) 423-2320


Revisions

| No. | By | Date | Description |
|---|---|---|---|
| 1 | | | |
| 2 | | | |
| 3 | | | |
| 4 | | | |
| 5 | | | |

Project: BRECKENRIDGE

Sheet Title: DRAINAGE PLAN

Scale: 1"=60'

| | |
|---|---|
| Designed By: KJP | Job Number: 109-97-5 |
| Drawn By: RRB | Date: 2-4-97 |
| Checked By: - | Filename: SUBPLAT.DWG |

Sheet Number: DR-1