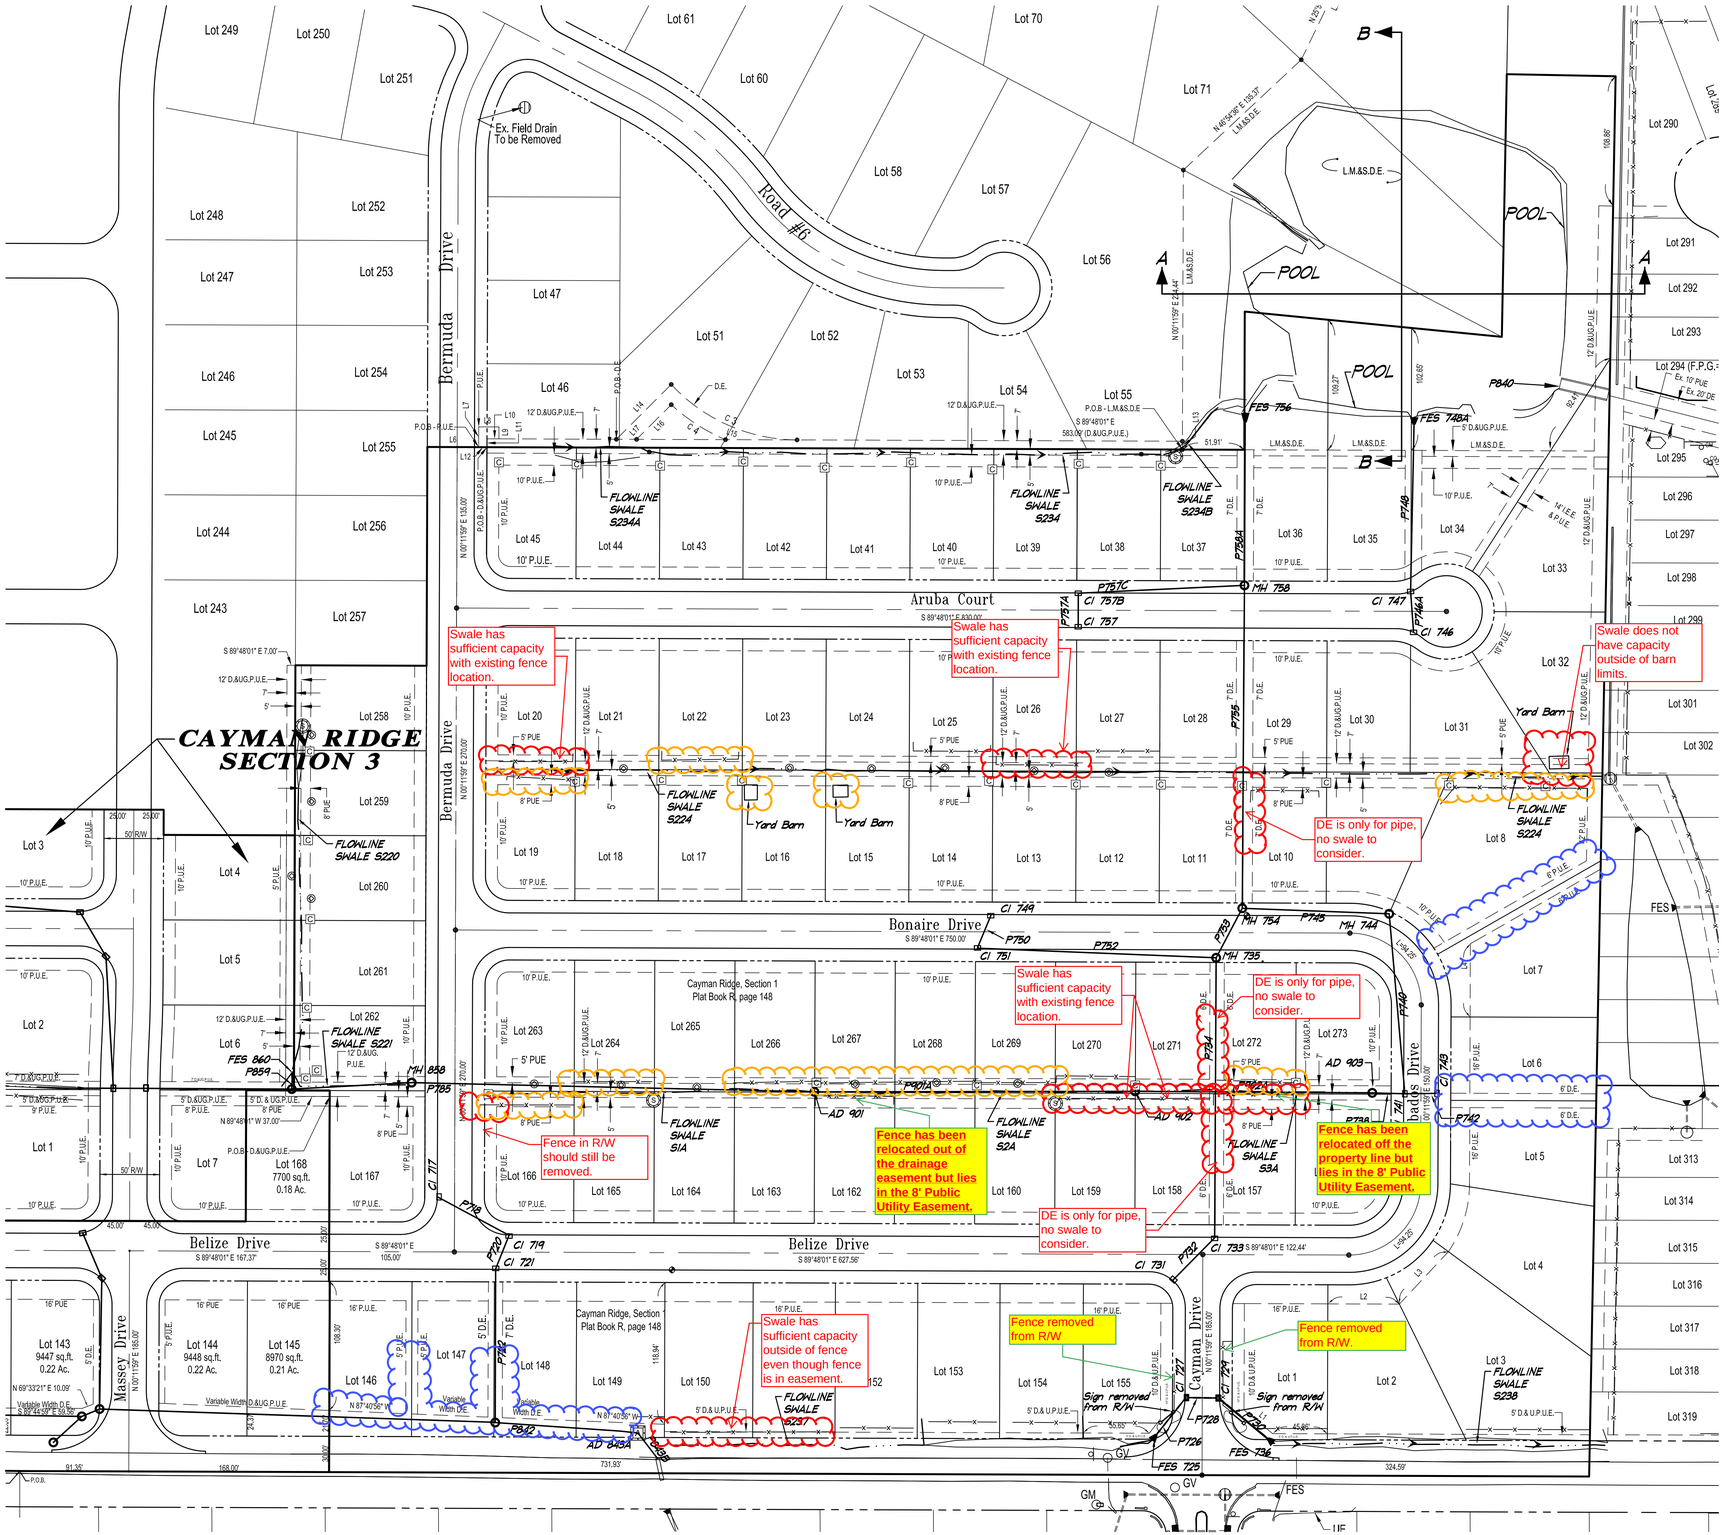

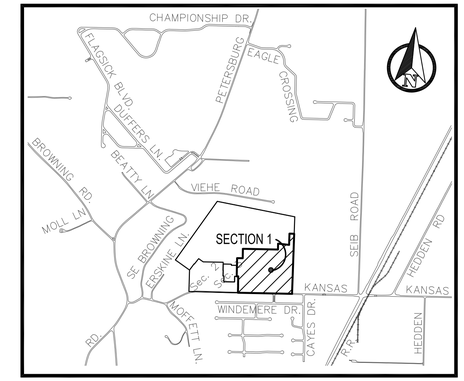

Location Map
No Scale

SCALE 1" = 60'

60 0 60 120

Legend

(R) – Record
(M) – Measured
(C) – Calculated
L.M.&S.D. Easement – Lake Maintenance & Storm Drainage Easement
R/W – Right-of-Way
B.S.L. – Building Setback Line
TOB – Swale Top of Bank
TOS – Swale Toe of Slope
Curb Inlet
Storm Pipe w/ FES
Storm Manhole / Area Drain
Swale Flowline

I, James E. Morley, certify and affirm that the completed storm water drainage system for this project is in general compliance with the Final Drainage Plan as approved by the Vanderburgh County Drainage Board, except as listed below:
1. S219 was not installed, P855 installed instead.

Signature

PE 10100250

Indiana Registration Number

Engineering
Surveying
Architecture
Construction Management

Morley and Associates Inc.

Evansville, In (812) 464-9585
Henderson, Ky (270) 830-0300
Jasper, In (812) 634-9950
www.morleyandassociates.com

All ideas, designs, calculations, and arrangements indicated or represented by this drawing are owned by and are the property of Morley and Associates, Inc. and shall not be used for any purpose not specified in connection with the project, without the written consent of Morley and Associates, Inc. This drawing is protected by copyright and other rights, including copyrights. No drawings or electronic files shall be transferred to any other person or firm without the written consent of Morley and Associates, Inc. Drawings and electronic files are to be used by any other person or firm without the written prior consent of Morley and Associates, Inc.
Written dimensions on these drawings shall have precedence over scale dimensions. Contractors shall verify and be responsible for all dimensions and conditions on the job site. Morley and Associates, Inc. must be notified of any variations from the dimensions and conditions shown by these drawings.
If dimensions exist between electronic files and the signed and sealed hard copy drawings, the hard copy shall govern.

Revisions

No.	By	Date	Description

JAMES E. MORLEY REGISTERED No. 10100250 STATE OF INDIANA PROFESSIONAL ENGINEER

Project Client: Cayman Ridge
Baywood Development, LLC

Sheet Title: **Record - Section 1 Drainage Plan**

Scale: 1" = 60'

Designed By: JEM	Job Number: 5811-4(B)
Drawn By: DWN	Date: 05-12-2014

Filename: J:\5811\Surveying\5811 Survey Base-2013.dwg

Sheet Number: **C-3** Rec-Storm Sec. 1

Sheet : 1 of 2