
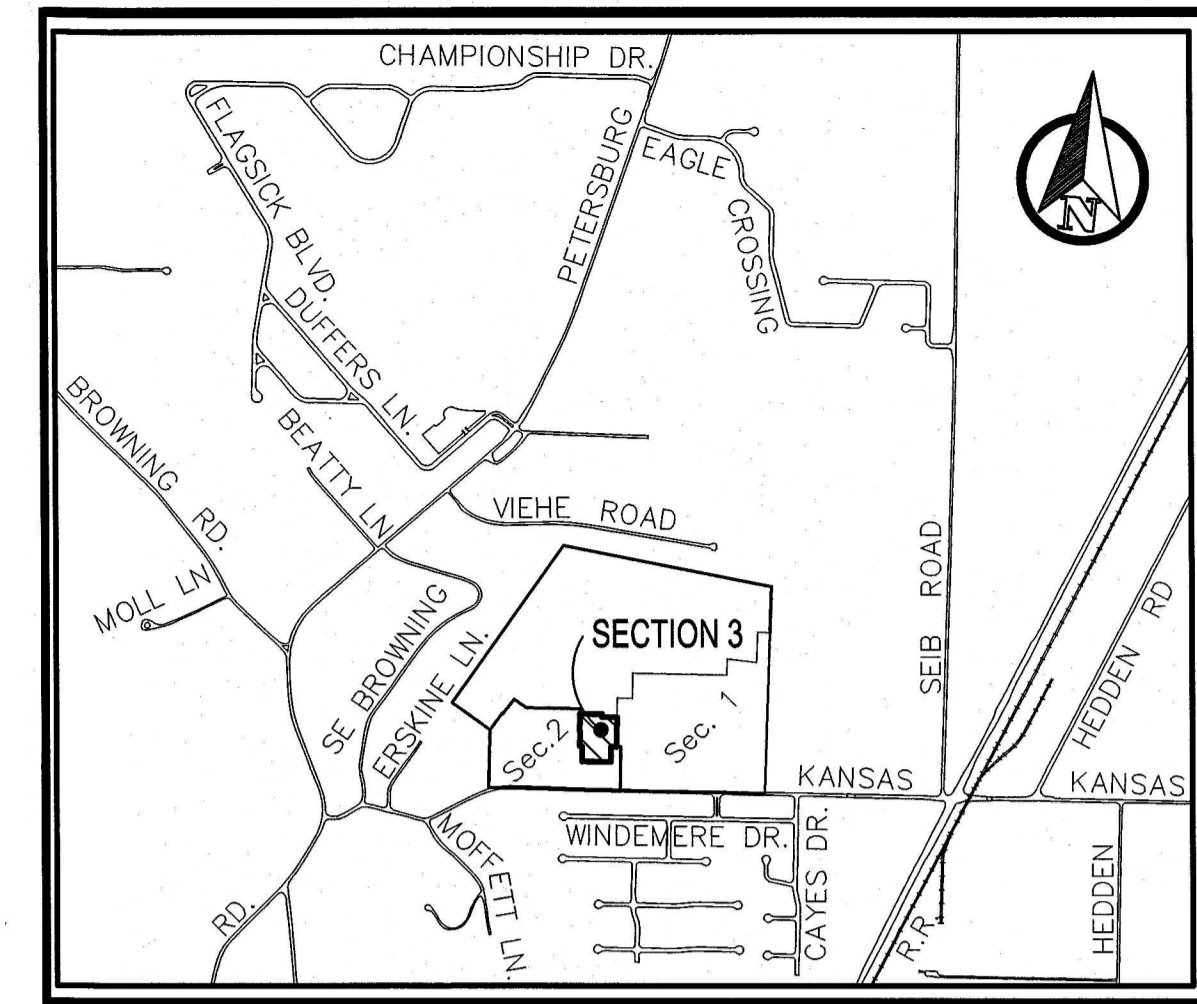


SCALE 1" = 50'

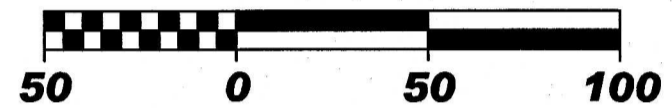


Location Map
No Scale

STORM-STRUCTURE DATA TABLE							
STRUCTURE NUMBER	SIZE	DESCRIPTION	LENGTH	FLOW LINE			Rim = AD Rim = MH FG = CI IE = FES
				UP STREAM	DOWN STREAM	SLOPE	
	In.		ft.	Elev.	Elev.	%	Elev.
P 790	12	R.C.P. CL. III	91.20	418.12	415.89	2.45	--
CI 791	--	Curb Inlet	--	415.89	415.77	--	418.96
P 792	18	R.C.P. CL. III	43.08	415.77	415.58	0.44	--
CI 793	--	Curb Inlet	--	415.58	415.50	--	418.80
P 794	18	R.C.P. CL. III	110.69	415.50	413.35	1.94	--
CI 795	--	Curb Inlet	--	413.35	413.09	--	415.94
P 852	12	R.C.P. CL. III	24.09	418.14	413.35	1.03	--
FES 851	12	Flared End Section	6.08	418.20	418.14	1.03	418.20
P 853	18	R.C.P. CL. III	28.16	413.09	412.62	1.67	--
CI 854	--	Curb Inlet	--	412.62	412.52	--	415.79
P 855	21	R.C.P. CL. III	121.44	412.52	411.20	1.08	--

DRAINAGE-SWALE DATA TABLE								
SWALE NUMBER	UP STREAM STRUC.	DOWN STREAM STRUC.	LENGTH	DEPTH	FLOW LINE			CONCRETE RIBBON
					UP STREAM	DOWN STREAM	SLOPE	
			ft.	ft.	Elev.	Elev.	%	
S219*	C854	AD856	N/A	N/A	N/A	N/A	N/A	N/A

* S219 was not installed.

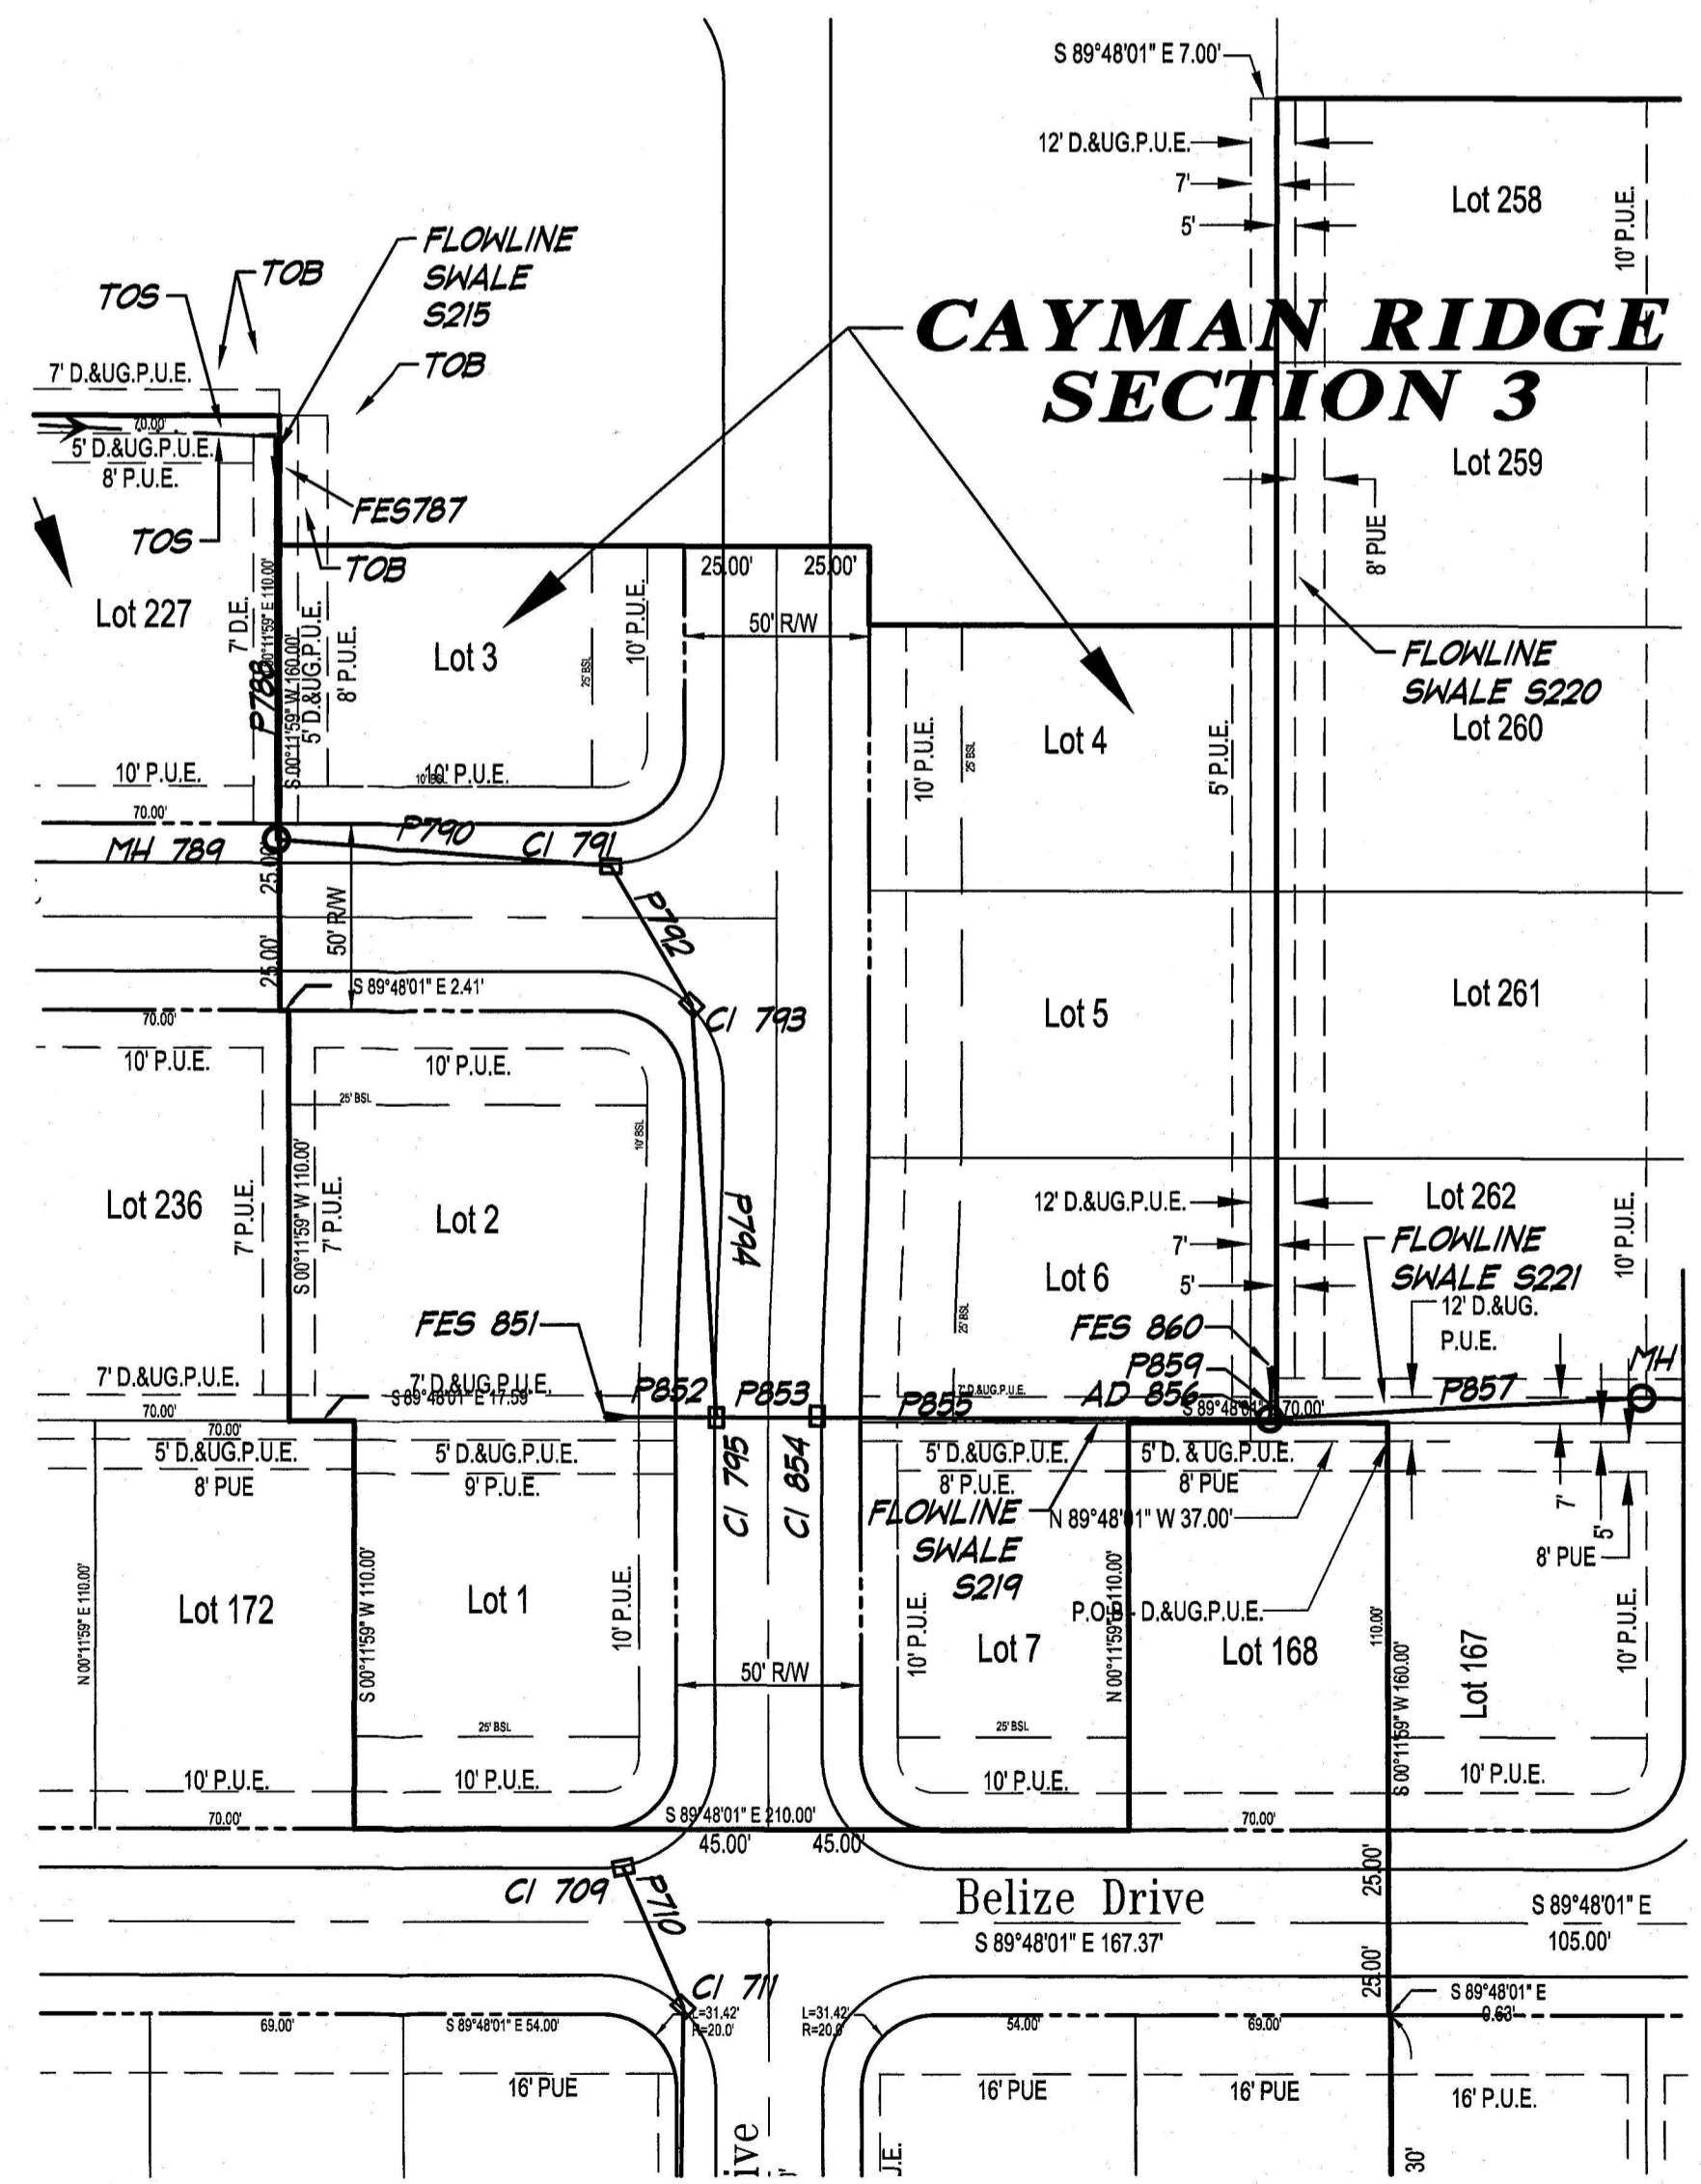

- Legend**
- (R) - Record
 - (M) - Measured
 - (C) - Calculated
 - L.M.&S.D. Easement - Lake Maintenance & Storm Drainage Easement
 - R/W - Right-of-Way
 - B.S.L. - Building Setback Line
 - TOB - Swale Top of Bank
 - TOS - Swale Toe of Slope
 - - Curb Inlet
 - - Storm Pipe w/ FES
 - - Storm Manhole / Area Drain
 - - Swale Flowline

I, James E. Morley, certify and affirm that the completed storm water drainage system for this project is in general compliance with the Final Drainage Plan as approved by the Vanderburgh County Drainage Board, except as listed below:
1. S219 was not installed, P855 installed instead.

Signature _____
PE 10100250
Indiana Registration Number _____

Engineering
Surveying
Architecture
Construction Management

Morley and Associates Inc.

Evansville, IN
Henderson, KY
Jasper, IN

(717) 464-9825
(217) 538-0300
(612) 654-9960

www.morleyandassociates.com

All ideas, designs, calculations, and arrangements indicated or represented by this drawing are owned by and are the property of Morley and Associates, Inc. and its affiliates. No part of this drawing shall be reproduced, stored in a retrieval system, or transmitted in any form or by any means, electronic, mechanical, photocopying, recording, or by any information storage and retrieval system, without the prior written permission of Morley and Associates, Inc. This drawing is not to be used for any other project or for any other person or firm without the written consent of Morley and Associates, Inc. The user of this drawing shall be responsible for all dimensions and conditions shown on this drawing. The user shall verify all dimensions and conditions shown on this drawing against the original drawings and the signed and sealed hard copy drawings. The hard copy shall govern.

Revisions			
No.	By	Date	Description

JAMES E. MORLEY
REGISTERED
STATE OF INDIANA
PROFESSIONAL ENGINEER
No. 10100250
5-12-14

Project Client: Cayman Ridge Baywood Development, LLC

Project Name: Record - Section 3 Drainage Plan And Structure Data Tables

Scale: 1" = 50'

Designed By: JEM Job Number: 5811-4(B)

Drawn By: DWN Date: 05-12-2014

Filename: J:\5811(Surveying)\5811 Survey Base-2013.dwg

Sheet Number: C-3 Rec-Storm Sec. 3