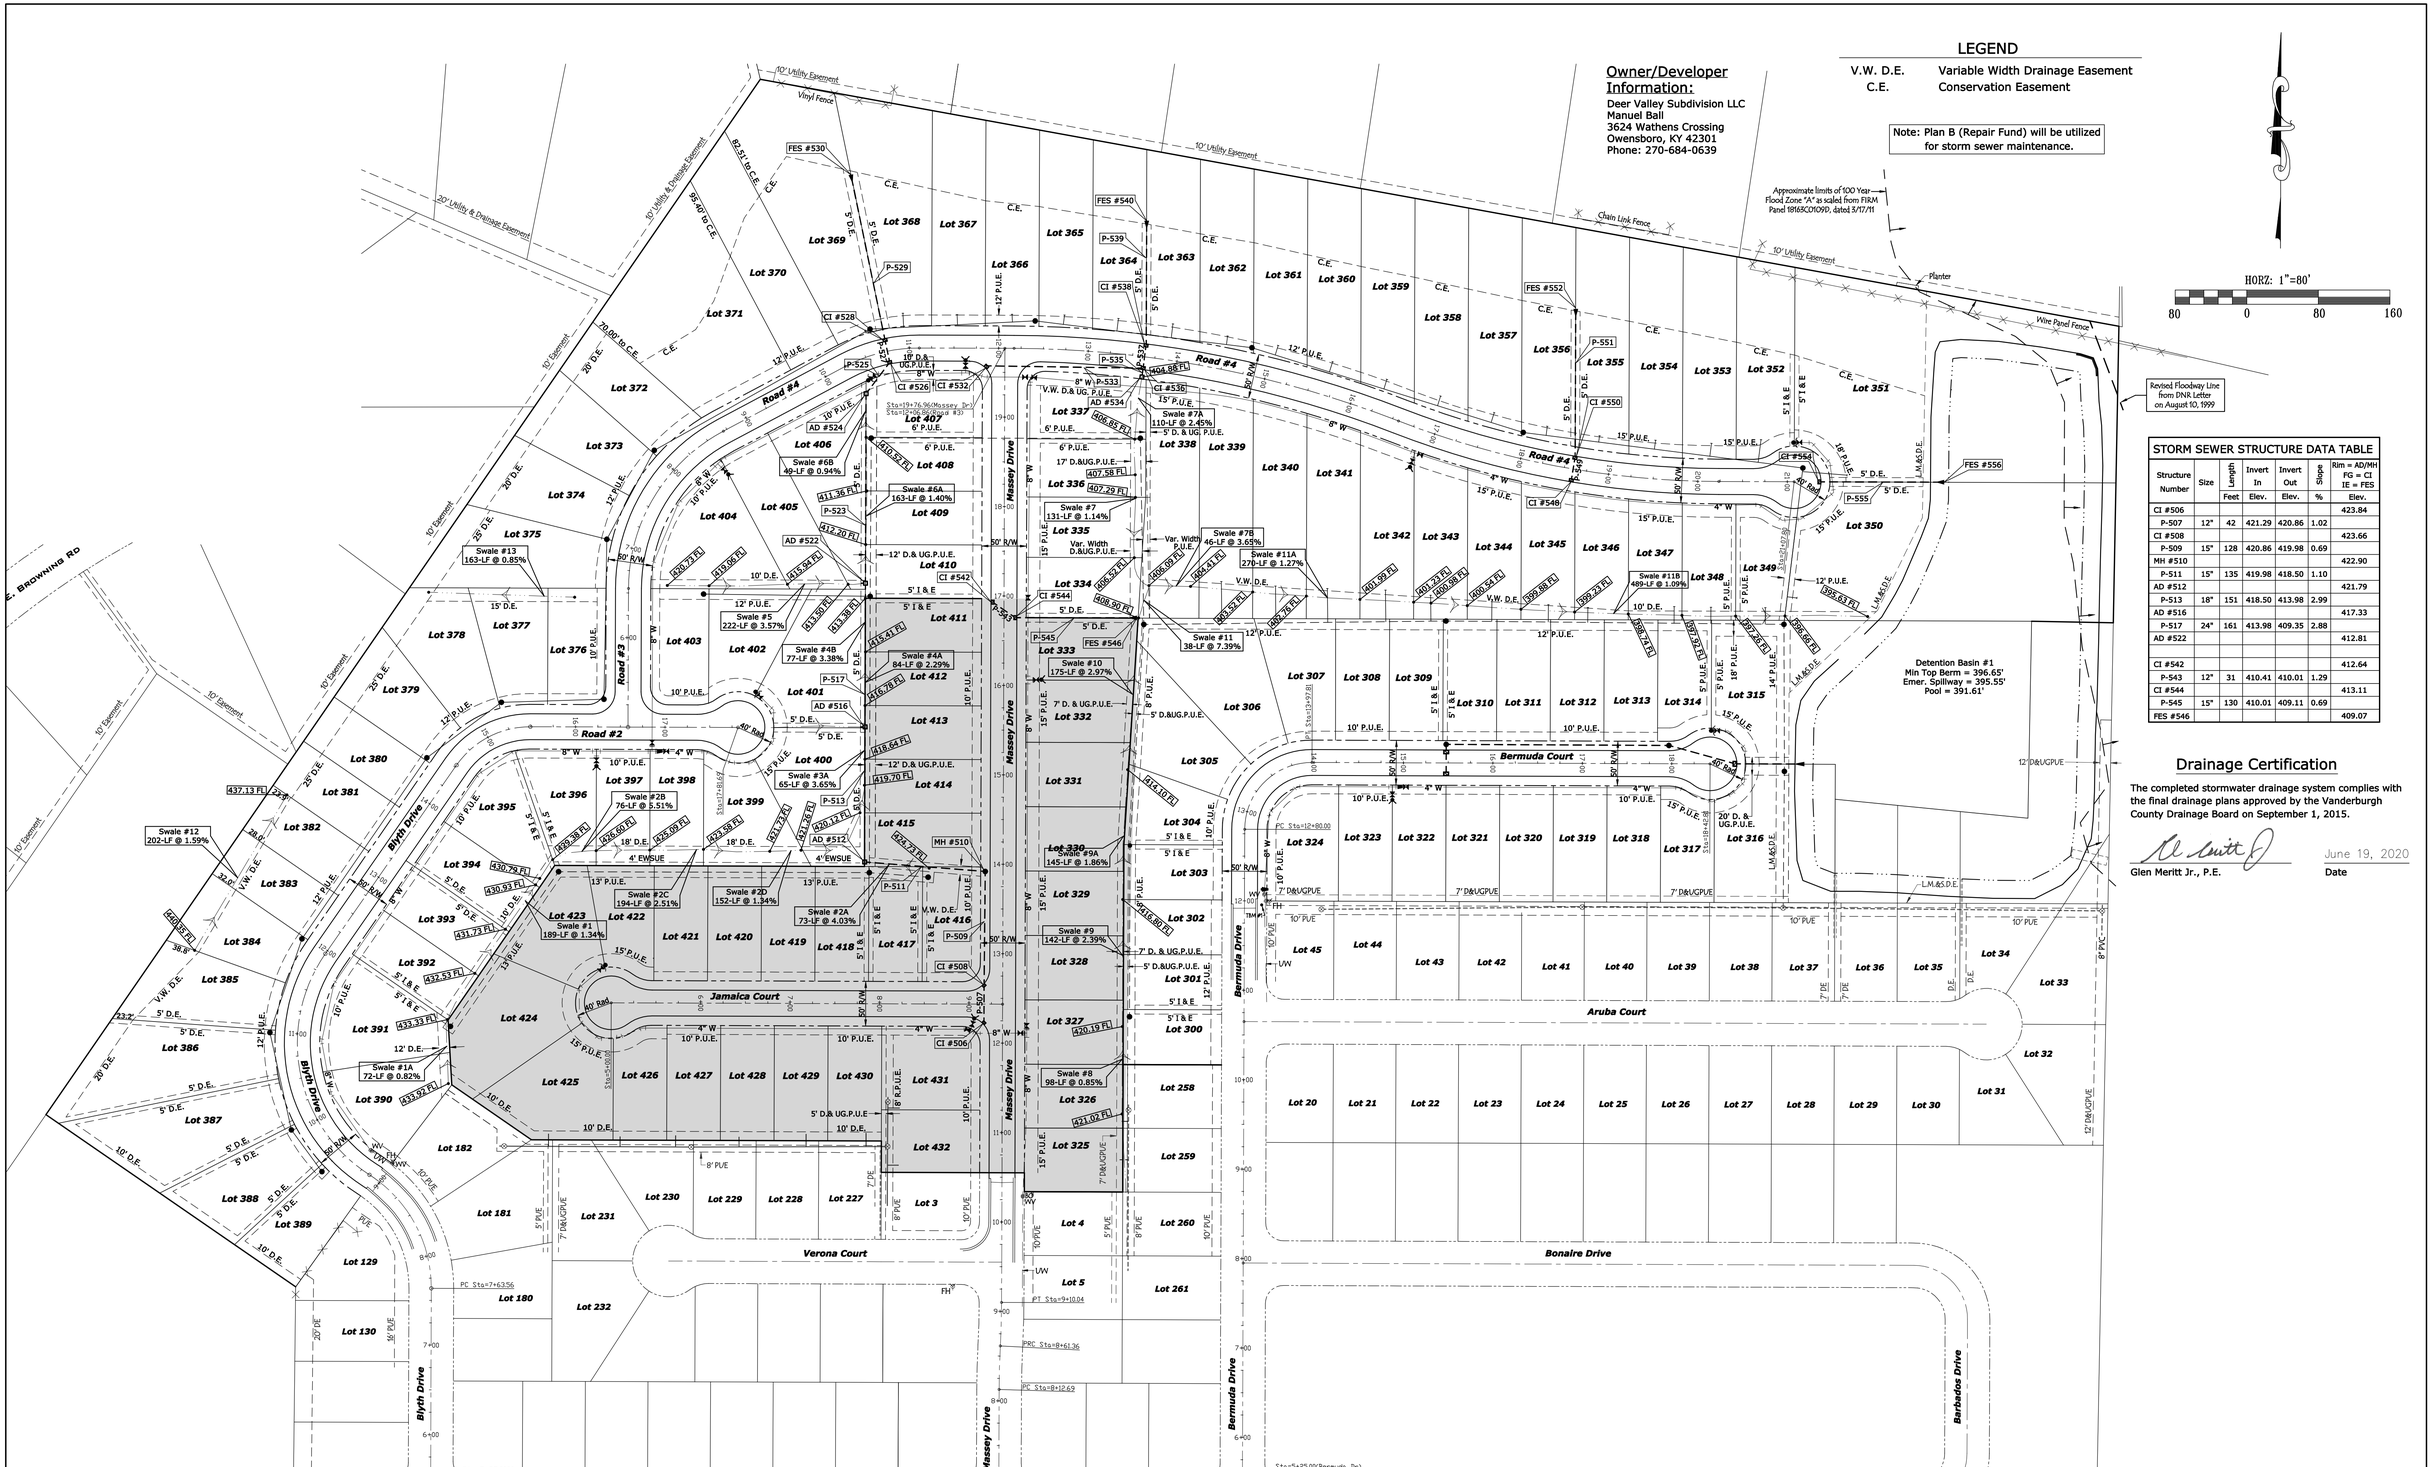

Owner/Developer Information:

Deer Valley Subdivision LLC
Manuel Ball
3624 Wathens Crossing
Owensboro, KY 42301
Phone: 270-684-0639

LEGEND

V.W. D.E.	Variable Width Drainage Easement
C.E.	Conservation Easement

Note: Plan B (Repair Fund) will be utilized for storm sewer maintenance.

STORM SEWER STRUCTURE DATA TABLE

Structure Number	Size	Length	Invert In	Invert Out	Slope	Rim = AD/MH FG = CI IE = FES
		Feet	Elev.	Elev.	%	Elev.
CI #506						423.84
P-507	12"	42	421.29	420.86	1.02	
CI #508						423.66
P-509	15"	128	420.86	419.98	0.69	
MH #510						422.90
P-511	15"	135	419.98	418.50	1.10	
AD #512						421.79
P-513	18"	151	418.50	413.98	2.99	
AD #516						417.33
P-517	24"	161	413.98	409.35	2.88	
AD #522						412.81
CI #542						412.64
P-543	12"	31	410.41	410.01	1.29	
CI #544						413.11
P-545	15"	130	410.01	409.11	0.69	
FES #546						409.07

Drainage Certification

The completed stormwater drainage system complies with the final drainage plans approved by the Vanderburgh County Drainage Board on September 1, 2015.

Glen Meritt Jr., P.E.

June 19, 2020
Date

This drawing and/or specifications is provided as an instrument of service provided by Cash Waggner & Associates, PC and is intended for use on this project only. All drawings, specifications, designs, models, ideas, calculations, and arrangements appearing herein constitutes the original and unpublished Work of and remains the property of Cash Waggner & Associates, PC. Any reproduction, use or disclosure of the proprietary information contained herein without the prior written consent of the Cash Waggner & Associates, PC is strictly prohibited.

Written dimensions shown hereon shall take precedence over scaled dimensions. Contractors shall calculate and measure required dimensions. Notify Cash Waggner & Associates, PC with any variations in dimensions or conditions from those indicated on these drawings. This drawing was based on available information. Commencement of Work constitutes verification and acceptance of existing conditions.

Application of a material or equipment to Work installed by others conestitutes acceptance of that Work and assumption of responsibility for satisfactory installation.

GLEN A. MERITT, JR. REGISTERED No PE10403870 STATE OF INDIANA PROFESSIONAL ENGINEER

Signature — Date: 19 June 20

CASH WAGGNER & ASSOCIATES, PC
CONSULTING ENGINEERS • LAND SURVEYORS

414 Citadel Circle
Suite B
Evansville, IN 47715
Ph: 812.401.5561
Fax: 812.401.5563
Cell: 812.774.2988
E-Mail: gmeritt@cashwaggner.com

Revisions No.	Date	By	Description

Project No.:	14-1948
Designed by:	G.A.M.
Drawn by:	G.A.M.
Filename:	1948 Base 4-2 Record
Layout Tab:	Drainage
Scale:	As Shown

Project: Cayman Ridge - Sect. 4, Ph. 2
Address: Kansas Road, Evansville, Indiana
Sheet Title: **Drainage Plan Record Drawing**

Date: 06.19.20
Drawing No.: 1 of: 3