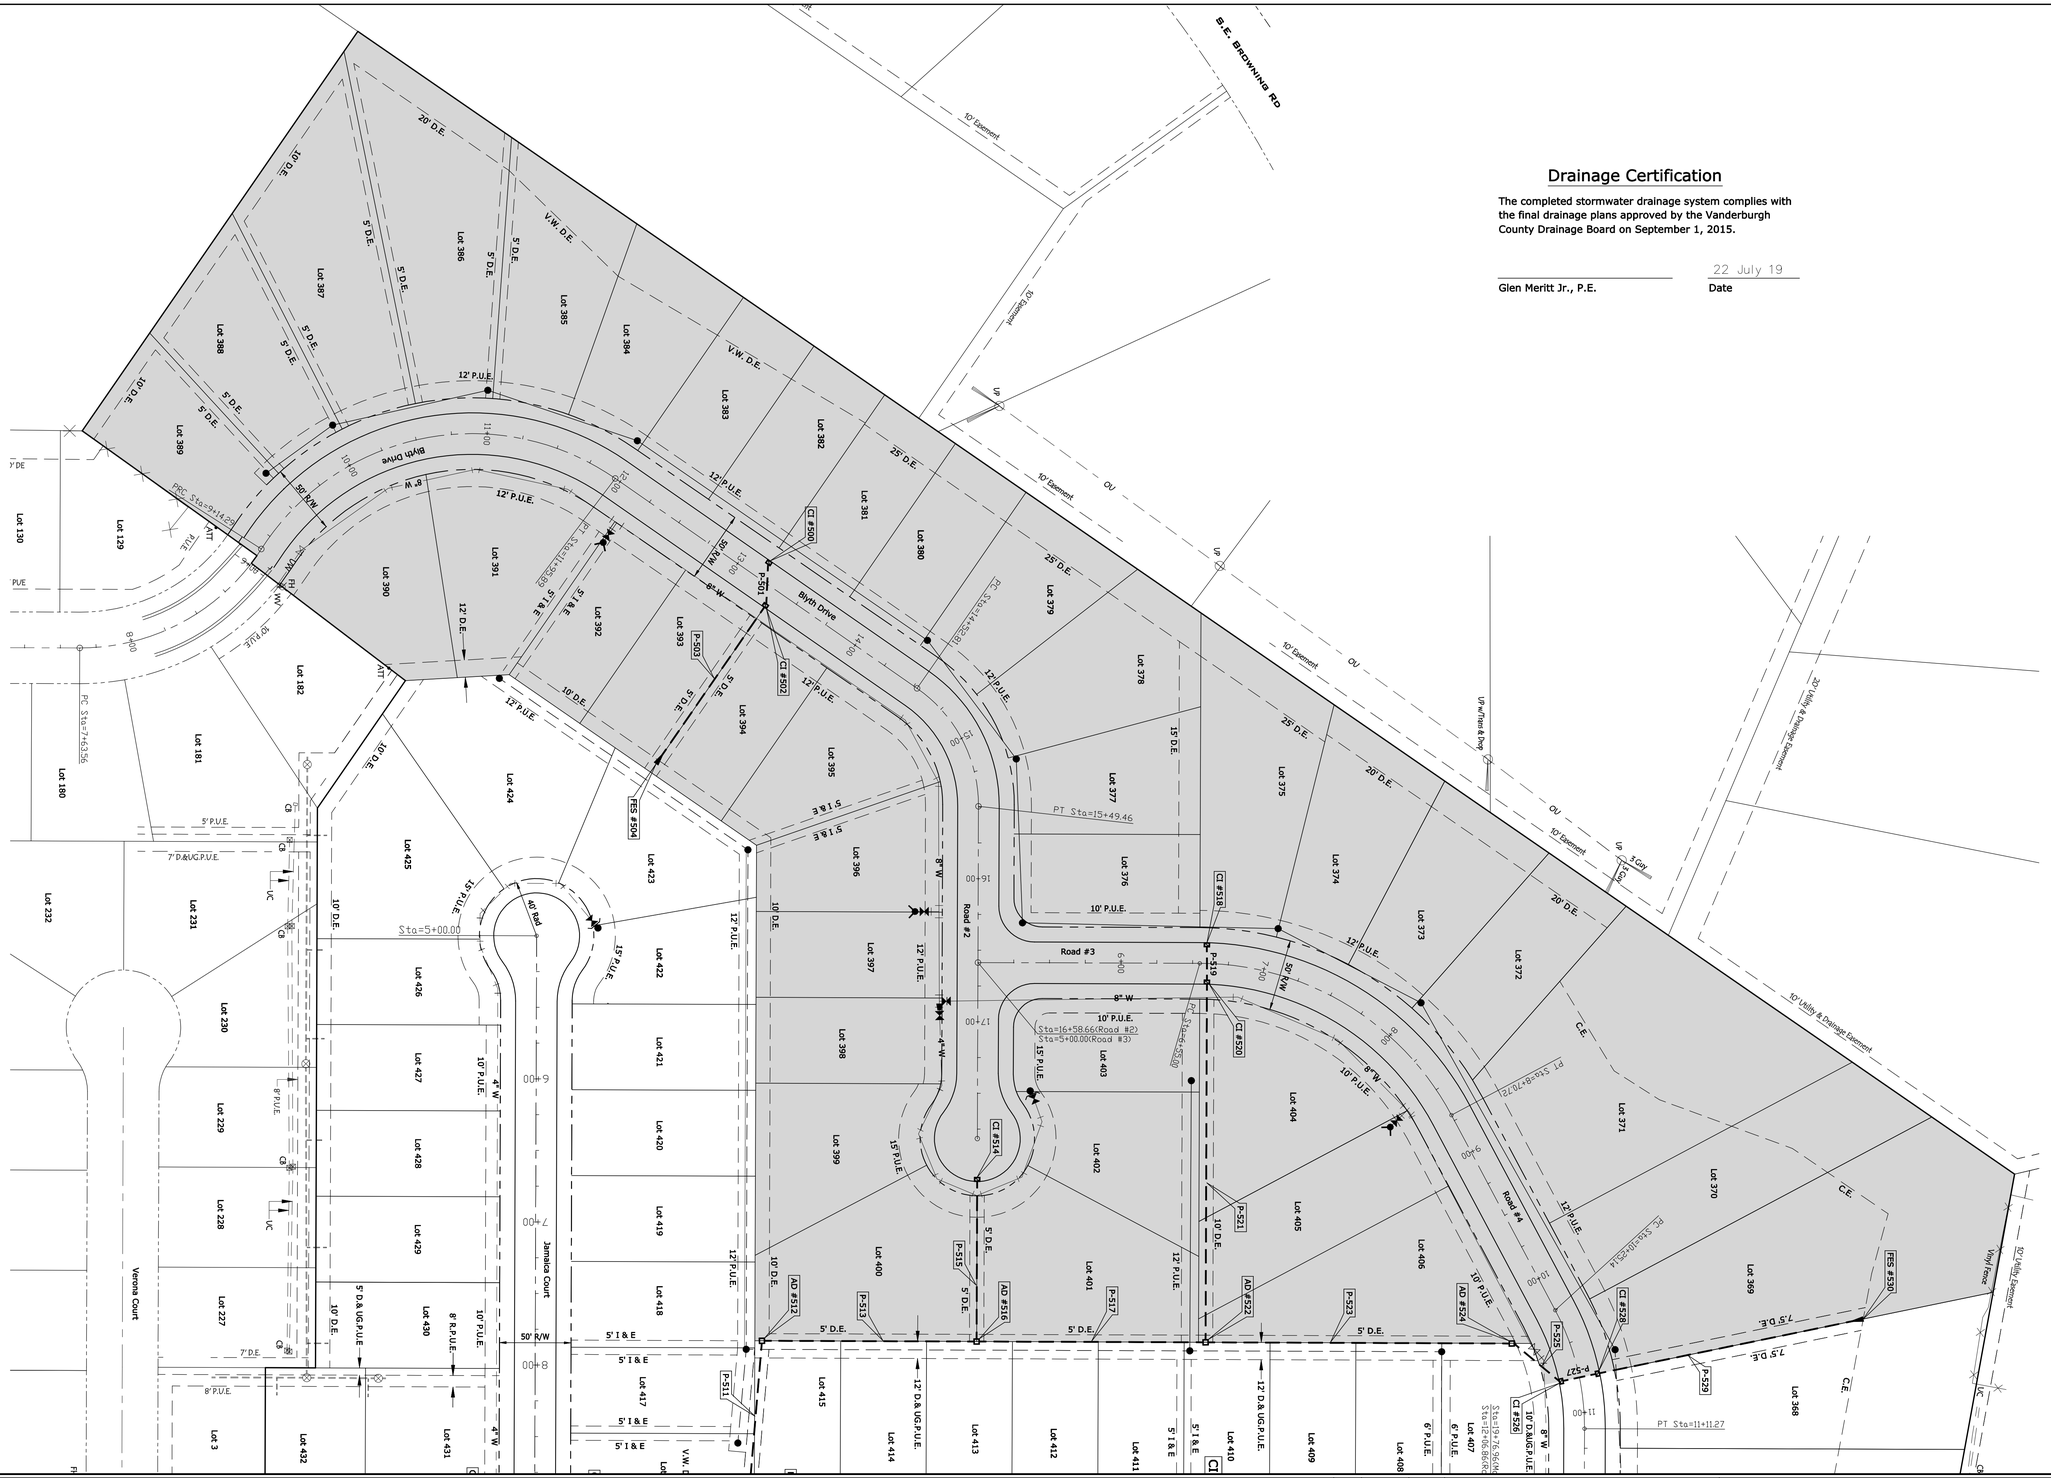

Drainage Certification

The completed stormwater drainage system complies with the final drainage plans approved by the Vanderburgh County Drainage Board on September 1, 2015.

Glen Meritt Jr., P.E. — Date: 22 July 19

HORZ: 1"=50'

50 0 50 100

LEGEND

Section 4 - Ph. 4

STORM SEWER STRUCTURE DATA TABLE

Structure Number	Size	Length	Invert In	Invert Out	Slope	Rim = AD/MH FG = CI IE = FES
		Feet	Elev.	Elev.	%	Elev.
CI #500						437.42
P-501	12"	30	435.16	434.60	1.87	
CI #502						436.87
P-503	15"	129	434.60	431.74	2.21	
FES #504						431.61
CI #514						417.21
P-515	15"	114	415.04	413.98	0.93	
CI #518						418.80
P-519	12"	26	416.72	416.56	0.62	
CI #520						418.77
P-521	12"	252	416.56	409.35	2.86	

This drawing and/or specifications is provided as an instrument of service provided by Cash Waggner & Associates, PC and is intended for use on this project only. All drawings, specifications, designs, models, ideas, calculations, and arrangements appearing herein constitutes the original and unpublished Work of and remains the property of Cash Waggner & Associates, PC. Any reproduction, use or disclosure of the proprietary information contained herein without the prior written consent of the Cash Waggner & Associates, PC is strictly prohibited.

Written dimensions shown hereon shall take precedence over scaled dimensions. Contractors shall calculate and measure required dimensions. Notify Cash Waggner & Associates, PC with any variations in dimensions or conditions from those indicated on these drawings. This drawing was based on available information. Commencement of Work constitutes verification and acceptance of existing conditions.

Application of a material or equipment to Work installed by others constitutes acceptance of that Work and assumption of responsibility for satisfactory installation.

GLEN A. MERITT, JR. REGISTERED No. PE10403870 STATE OF INDIANA PROFESSIONAL ENGINEER

Signature — Date: 22 July 19

CASH WAGGNER & ASSOCIATES, PC
CONSULTING | ENGINEERING | SURVEYING

414 Citadel Circle
Suite 8
Evansville, IN 47715
Ph: 812.401.5561
Fax: 812.401.5563
Cell: 812.774.2988
E-mail: gmeritt@cashwaggner.com

Revisions	No.	Date	By	Description

Project No.:	14-1948
Designed By:	G.A.M.
Drawn By:	A.W.W.
Filename:	1948 BASE RECORD 4-4
Layout Tab:	DRAINAGE 4-4
Scale:	As Shown

Project: Cayman Ridge - Sect. 4, Ph. 4

Address: Kansas Road, Evansville, Indiana

Sheet Title: **Drainage Plan Record Drawning**

Date: 07.22.19

Drawing No.: C-101

Of: