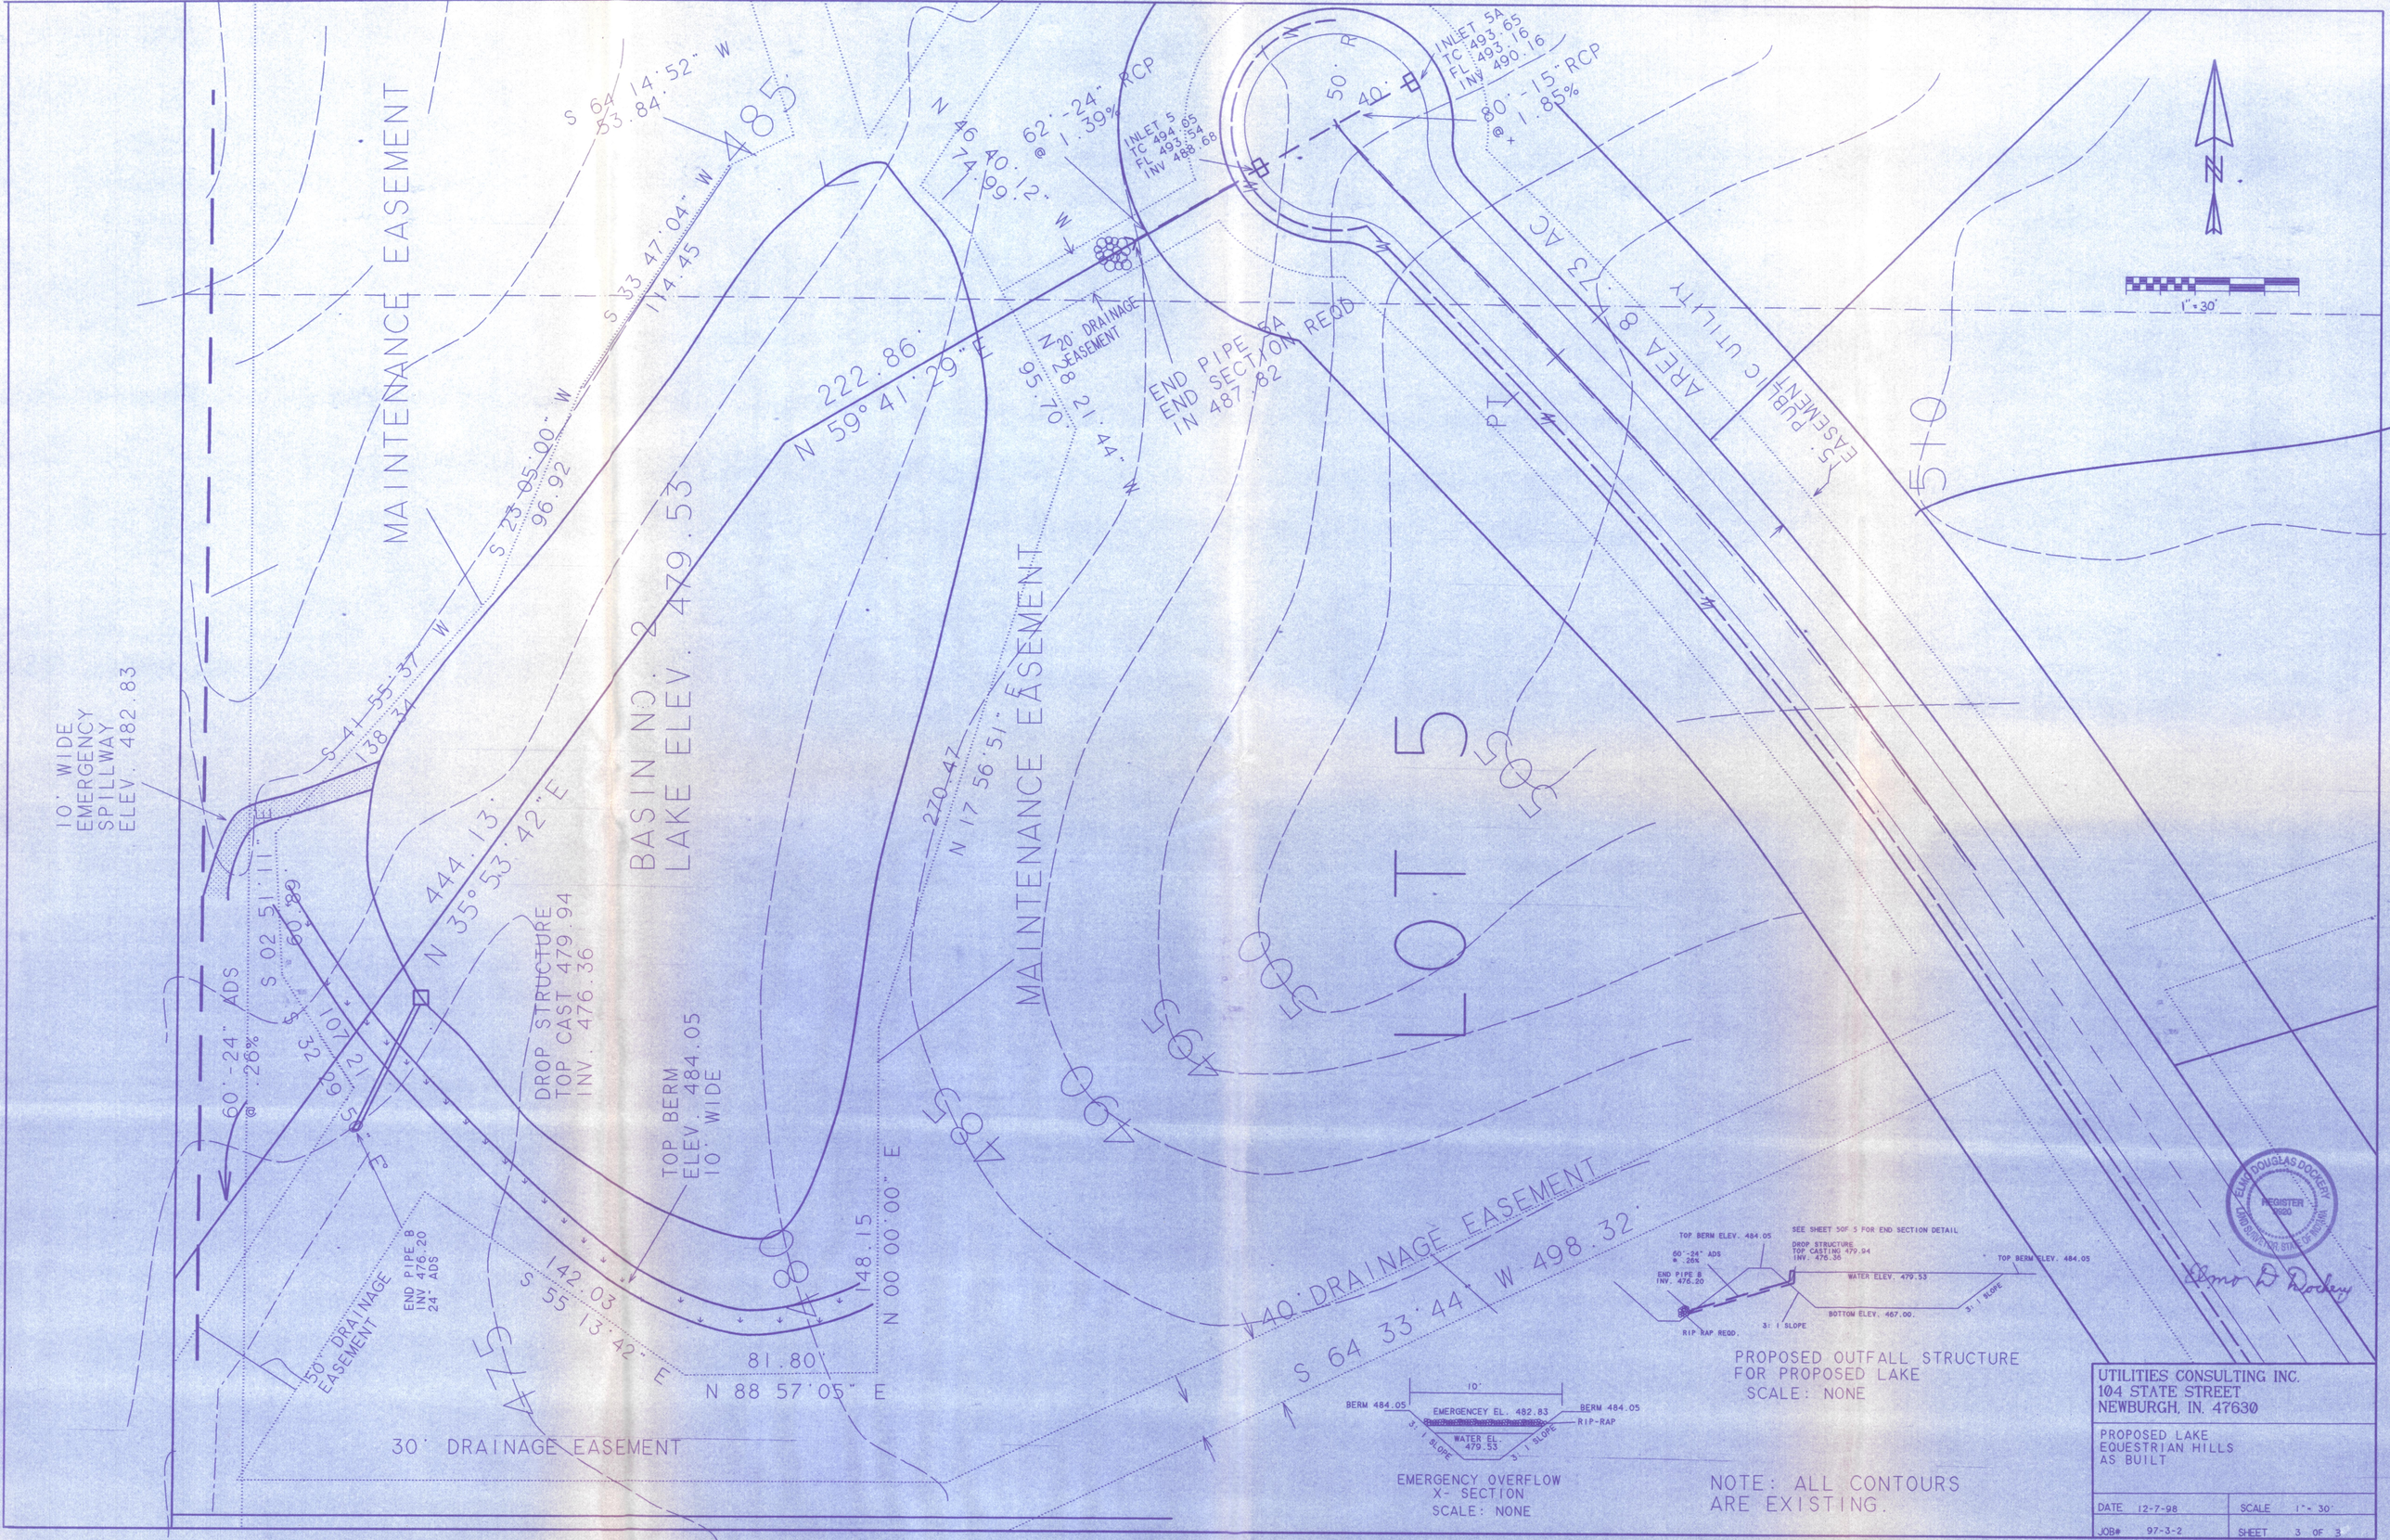

PROPOSED OUTFALL STRUCTURE
FOR PROPOSED LAKE
SCALE: NONE

EMERGENCY OVERFLOW
X- SECTION
SCALE: NONE

NOTE: ALL CONTOURS
ARE EXISTING.

ELMO DOUGLAS DOCKERY
REGISTER
9920
LAND SURVEYOR, STATE OF INDIANA

Elmo D Dockery

UTILITIES CONSULTING INC.
104 STATE STREET
NEWBURGH, IN. 47630

PROPOSED LAKE
EQUESTRIAN HILLS
AS BUILT

DATE 12-7-98	SCALE 1"= 30'
JOB# 97-3-2	SHEET 3 OF 3