



STORM SEWER LINE TABLE

LINE 101	- 119.07 LF - 15 DIA. AT 0.74%
LINE 201	- 176.04 LF - 24 DIA. AT 0.48%
LINE 202	- 64.49 LF - 24" DIA. AT 0.48%
LINE 203	- 121.17 LF - 24" DIA. AT 0.88%
LINE 204	- 158.73 LF - 15" AT 2.96%
LINE 205	- 179.90 LF - 15" AT 6.11%
LINE 206	- 129.50 LF - 15" DIA. AT 1.70%
LINE 207	- 29.00 LF - 12" DIA. AT 0.86%
LINE 208	- 200.77 LF - 12" DIA. AT 4.07%
LINE 209	- 30.73 LF - 12" DIA. AT 0.81%
LINE 210	- 16.53 LF - 12" DIA. AT 2.15%
LINE 211	- 29.00 LF - 12" DIA. AT 0.71%
LINE 401	- 145.96 LF - 42" DIA. AT 1.00%
LINE 402	- 29.00 LF - 42" DIA. AT 1.00%
LINE 403	- 130.51 LF - 42" DIA. AT 1.00%
LINE 404	- 130.60 LF - 30" DIA. AT 1.00%
LINE 405	- 71.68 LF - 30" DIA. AT 1.00%
LINE 406	- 70.65 LF - 30" DIA. AT 1.00%
LINE 407	- 12.71 LF - 21" DIA. AT 1.00%
LINE 408	- 34.66 LF - 30" DIA. AT 1.00%
LINE 409	- 139.61 LF - 30" DIA. AT 1.00%
LINE 410	- 76.65 LF - 30" DIA. AT 1.00%
LINE 411	- 171.71 LF - 30" DIA. AT 1.00%
LINE 412	- 130.48 LF - 30" DIA. AT 1.74%
LINE 413	- 29.00 LF - 30" DIA. AT 1.74%
LINE 414	- 38.57 LF - 30" DIA. AT 1.74%
LINE 415	- 29.00 LF - 15" DIA. AT 1.00%
LINE 416	- 57.61 LF - 15" DIA. AT 1.00%
LINE 417	- OMITTED
LINE 418	- 33.06 LF - 24" DIA. AT 9.38%
LINE 501	- 146.59 LF - 30" DIA. AT 0.80%
LINE 502	- 29.00 LF - 30" DIA. AT 1.02%
LINE 503	- 64.09 LF - 24" DIA. AT 1.02%
LINE 504	- 114.00 LF - 24" DIA. AT 1.02%
LINE 505	- 140.89 LF - 18" DIA. AT 2.83%
LINE 506	- 34.23 LF - 18" DIA. AT 2.00%
LINE 507	- 32.80 LF - 18" DIA. AT 1.00%
LINE 508	- 29.00 LF - 18" DIA. AT 1.00%
LINE 509	- 215.41 LF - 12" DIA. AT 3.38%
LINE 510	- 46.95 LF - 12" DIA. AT 1.50%
LINE 511	- 119.33 LF - 12" DIA. AT 4.33%
LINE 512	- 78.00 LF - 12" DIA. AT 1.26%
LINE 600	- 44.85 LF - 12" DIA. AT 4.35%
LINE 700	- 171.90 LF - 12" DIA. AT 2.11%

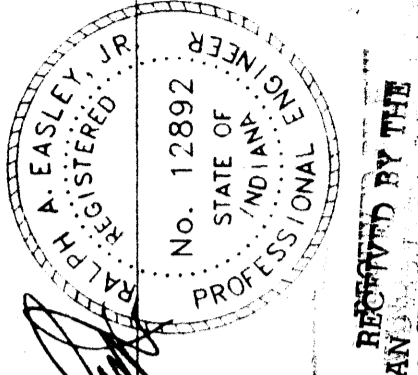

ANDY EASLEY ENGINEERING
 CIVIL ENGINEERING (EIT) 424-2481 LAND SURVEYING
 EVANSVILLE, INDIANA 47710
 1133 WEST MILL ROAD

Storm Drainage Plan
NEWBURGH LAKES
 Newburgh Development
 Vanderburgh County, Indiana

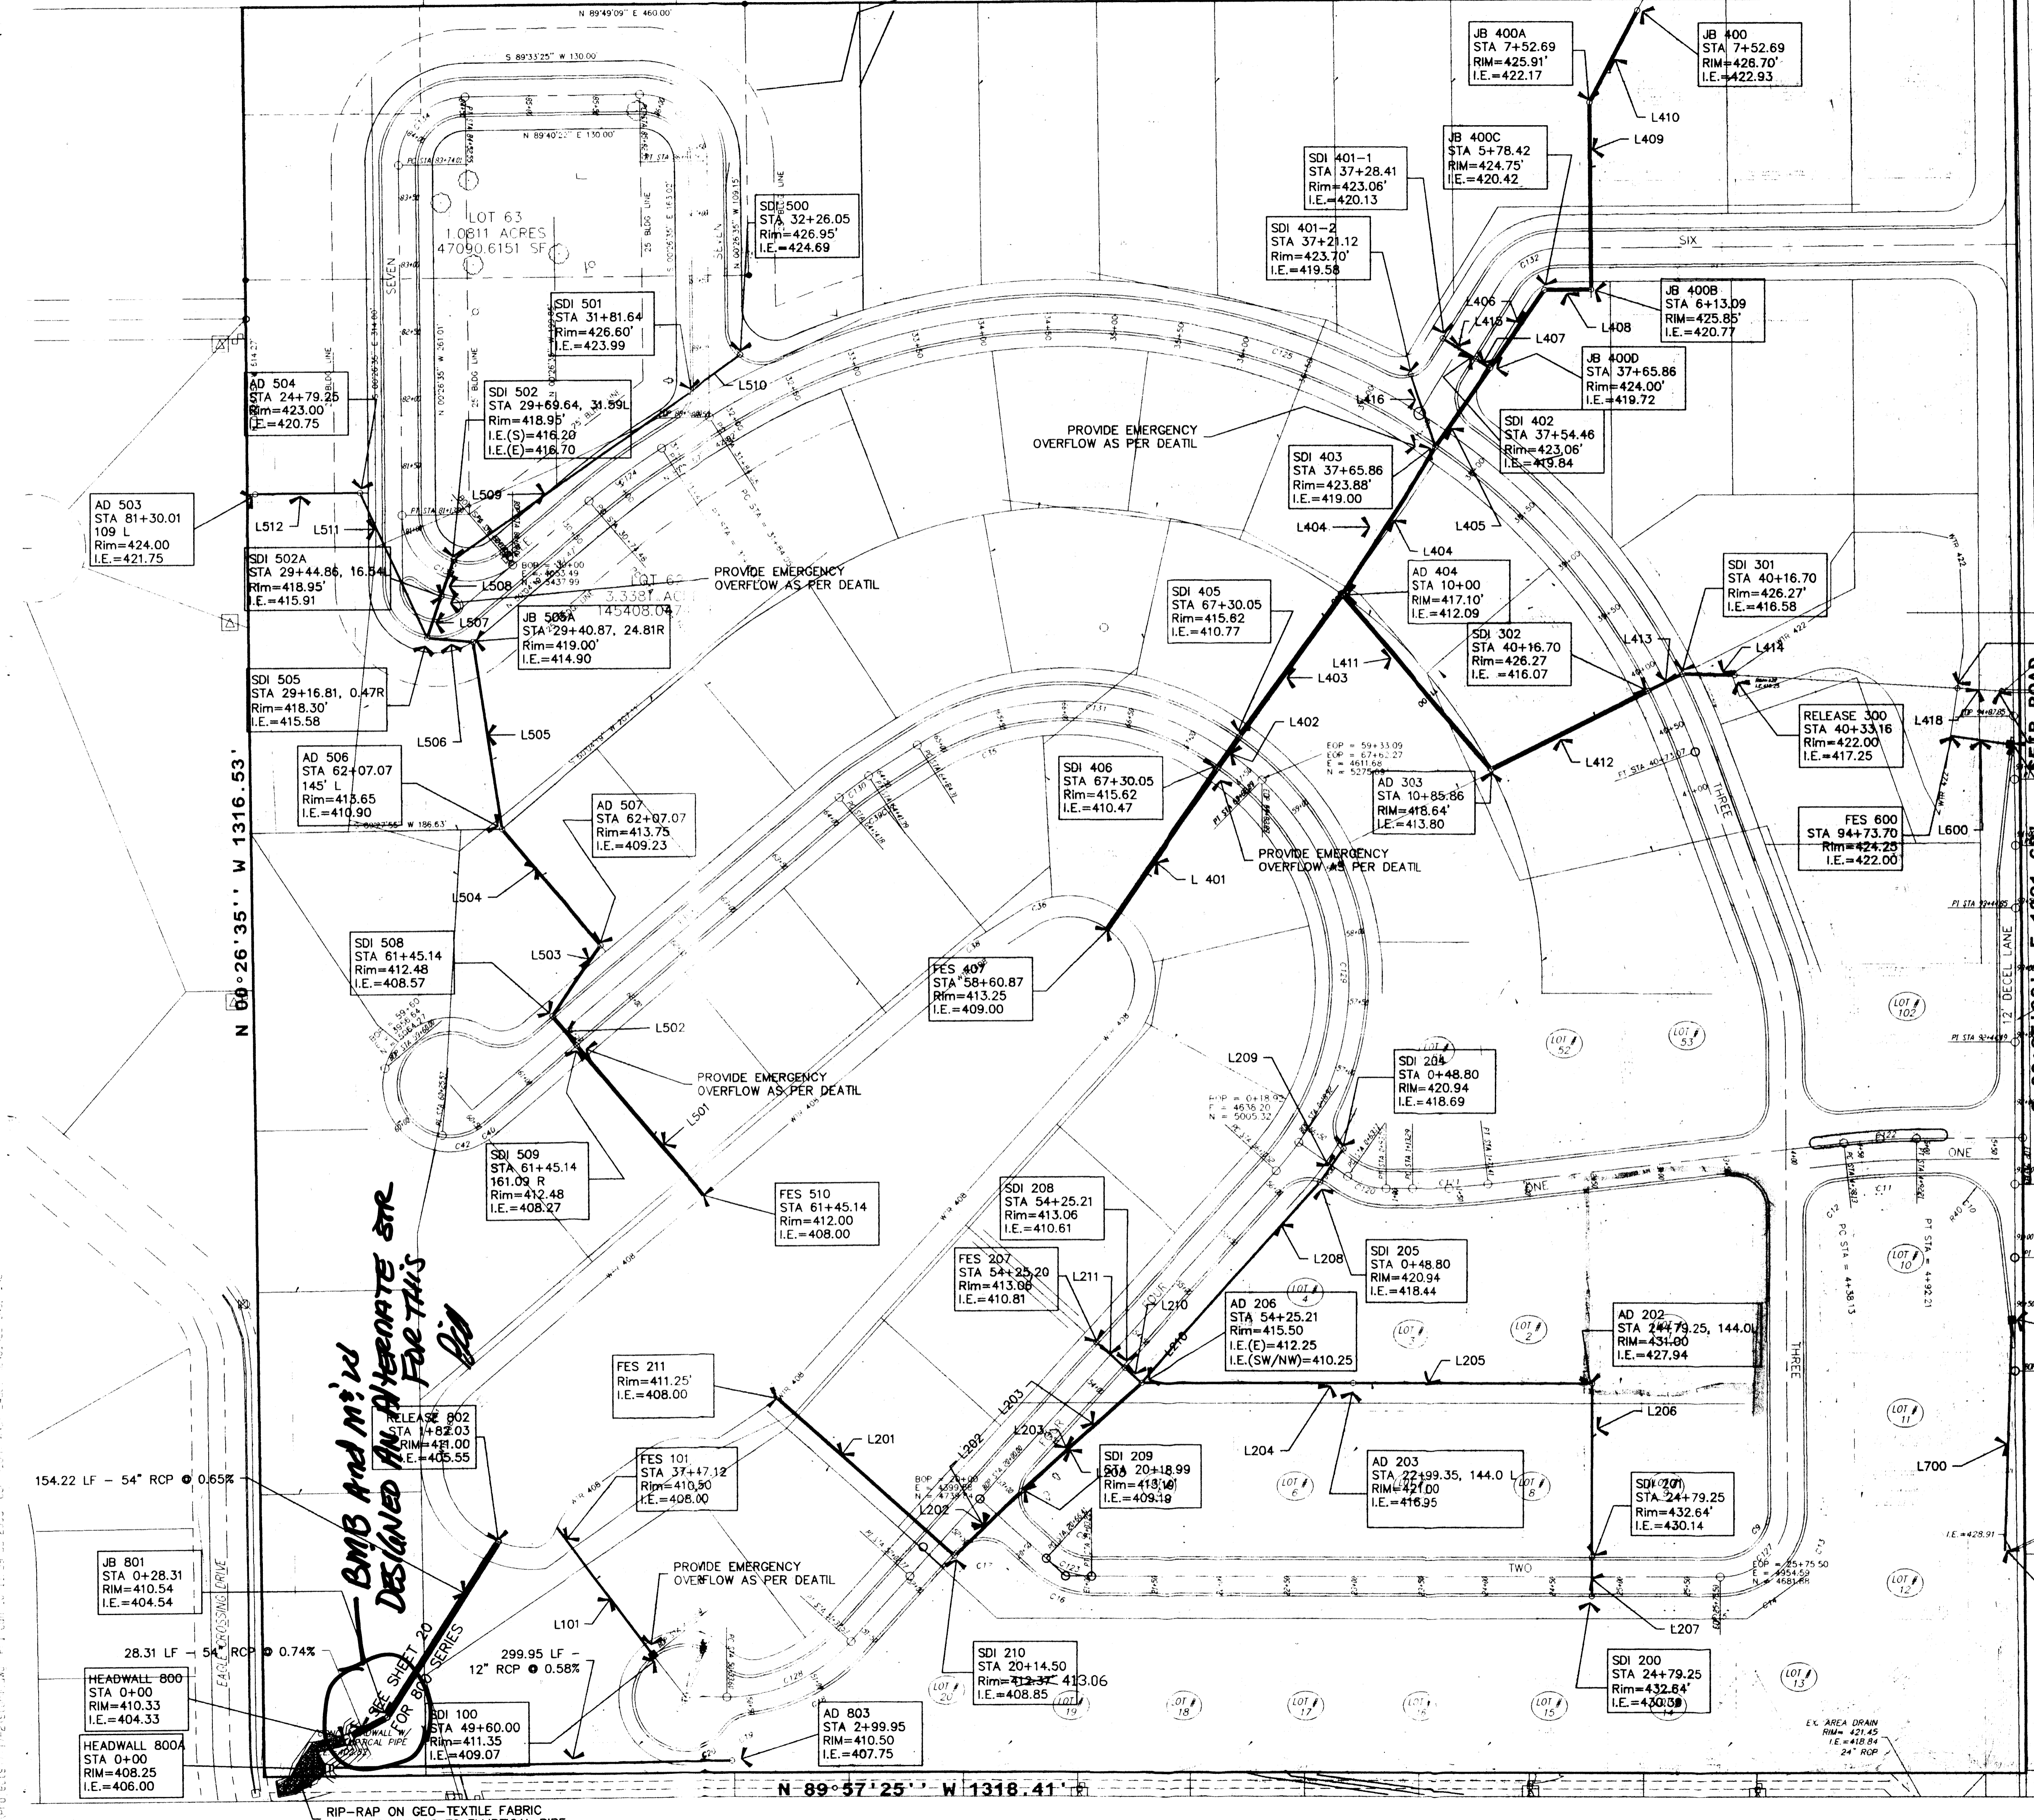











BMB And M.I.D. DESIGNED AN ALTERNATE SR FOR THIS AREA

RIP-RAP ON GEO-TEXTILE FABRIC FROM HEADWALLS TO ELLIPTICAL PIPE