


# Kinway Park

Heckel Road  
Vanderburgh County  
Evansville, Indiana

Location Map

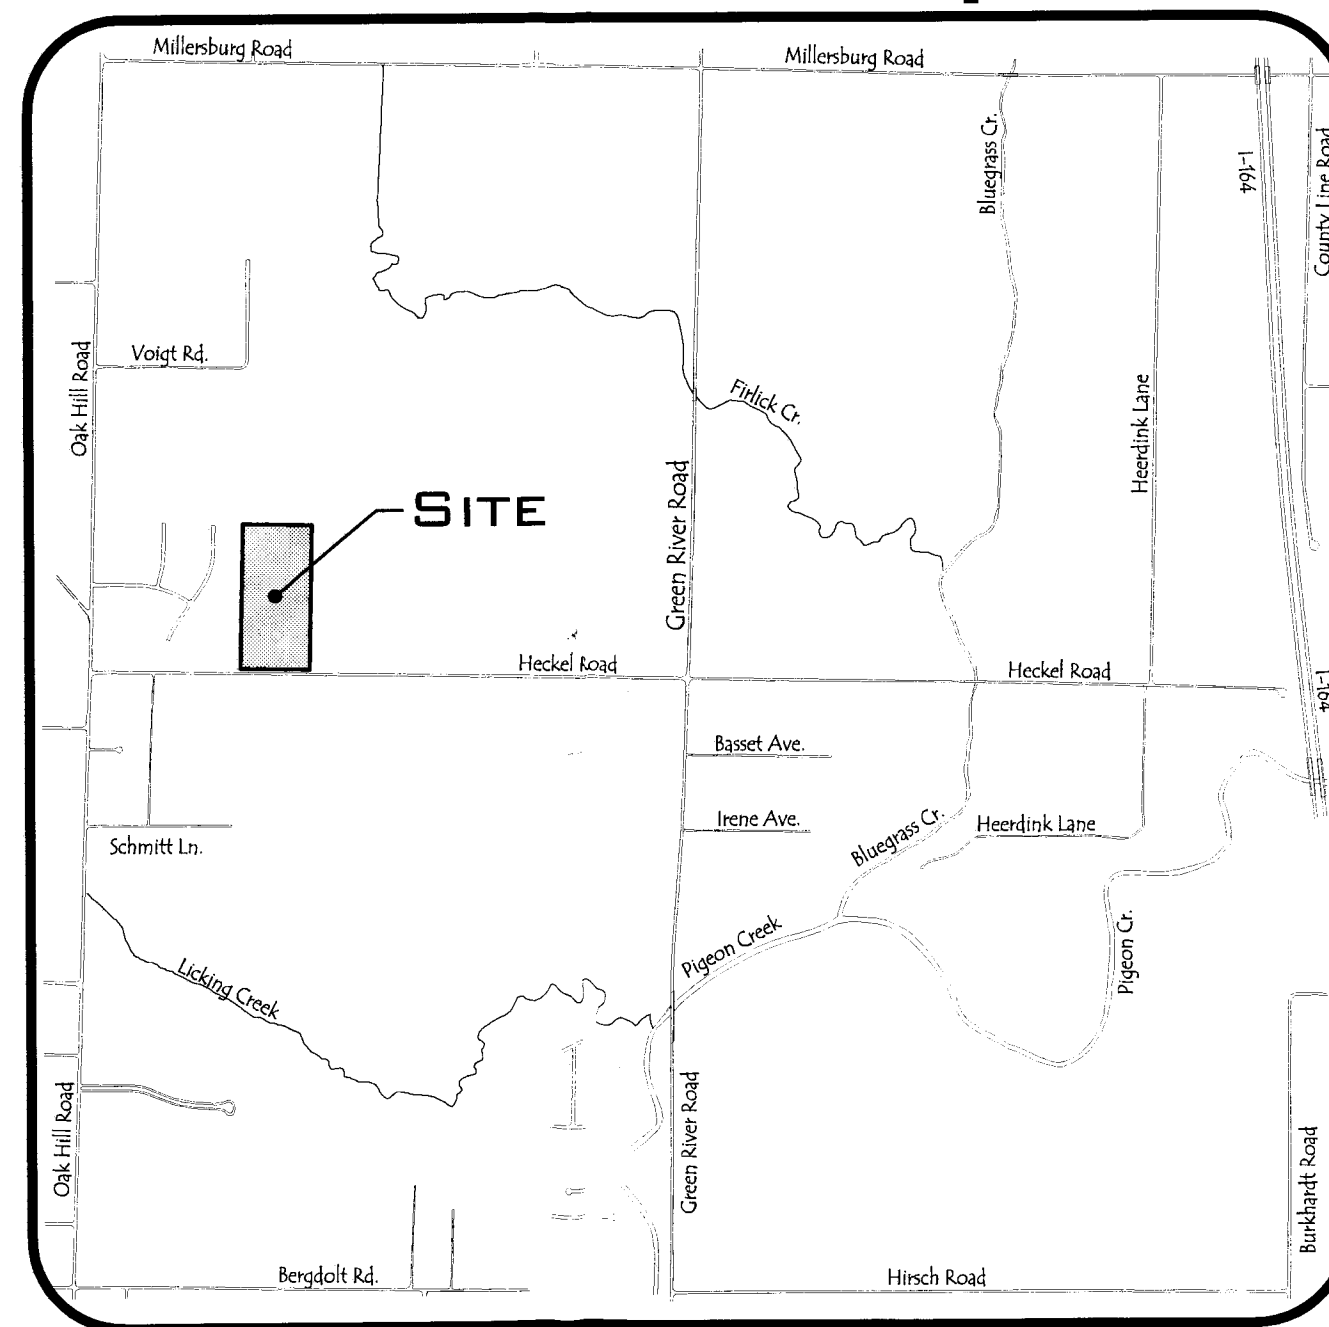

Drawing Index


SHEET NO.	DESCRIPTION:
C-100	TITLE SHEET
C-101	DRAINAGE PLAN
C-102	SANITARY SEWER PLAN <i>Not Provided</i>
C-103	POTABLE WATER SYSTEM PLAN <i>Not Provided</i>
C-104	KINWAY DRIVE - PLAN & PROFILE
C-105	ROAD #1 - PLAN & PROFILE
C-106	ROAD #2 - PLAN & PROFILE
C-107	ROAD #3 - PLAN & PROFILE
C-108	SANITARY SEWER PROFILES <i>Not Provided</i>
C-109	SWP3 NARRATIVE <i>Provided 10/9</i>
C-110	SWP3 - CONSTRUCTION PHASE <i>Not Provided</i>
C-111	SWP3 - POST CONSTRUCTION PHASE <i>Not Provided</i>
C-112	EROSION CONTROL DETAILS - <i>Not Provided</i>
C-113	ROAD & STORM SEWER DETAILS
C-114	DRAINAGE DETAILS
C-115	SANITARY SEWER DETAILS
C-116	SPECIFICATIONS <i>Not Provided</i>
C-117	EW&SU WATER DETAILS <i>Not Provided</i>

*Revised 10/9/2014*

*Revised 10/9/2014*

*Also Drawings 1, 2, 3*

Prepared By:

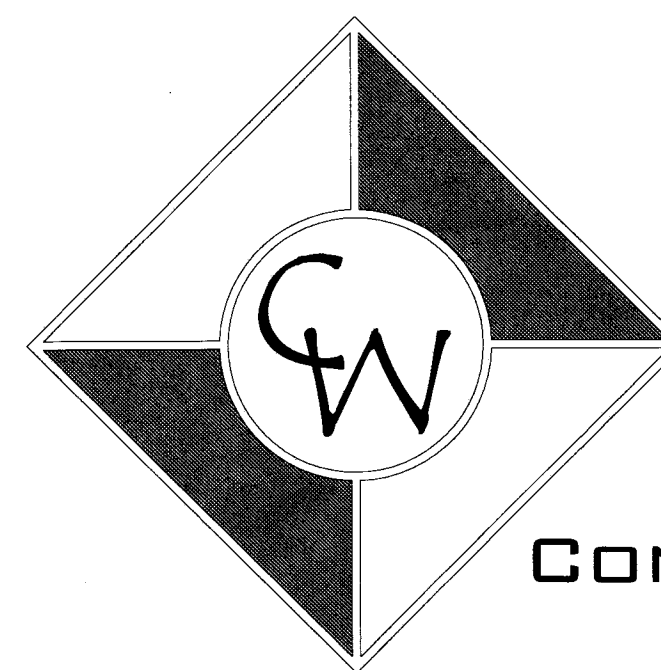

**CASH WAGGNER**

**& ASSOCIATES, PC**

CONSULTING ENGINEERS • LAND SURVEYORS

414 CITADEL CIRCLE  
SUITE B  
EVANSVILLE, IN 47715  
PH: 812.401.5561  
FAX: 812.401.5563  
CELL: 812.774.2988  
E-MAIL: GMRITT@CASHWAGGNER.COM

APPROVED  
OCT 14 2014  
VANDERBURGH COUNTY  
DRAINAGE BOARD

RECEIVED BY THE  
VANDERBURGH COUNTY  
SURVEYORS OFFICE

**C-100**  
09.16.14

Kinway Park