

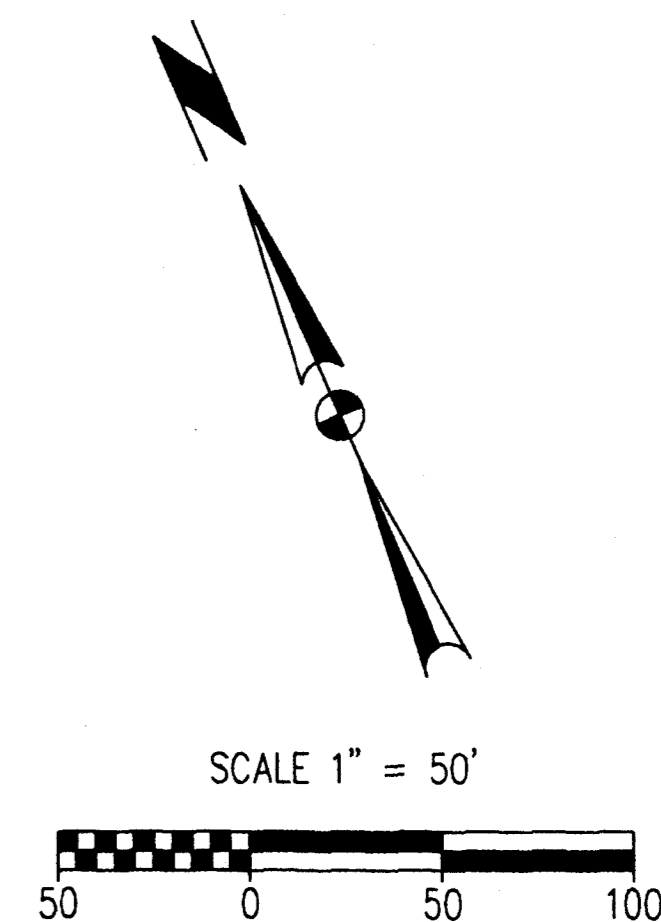
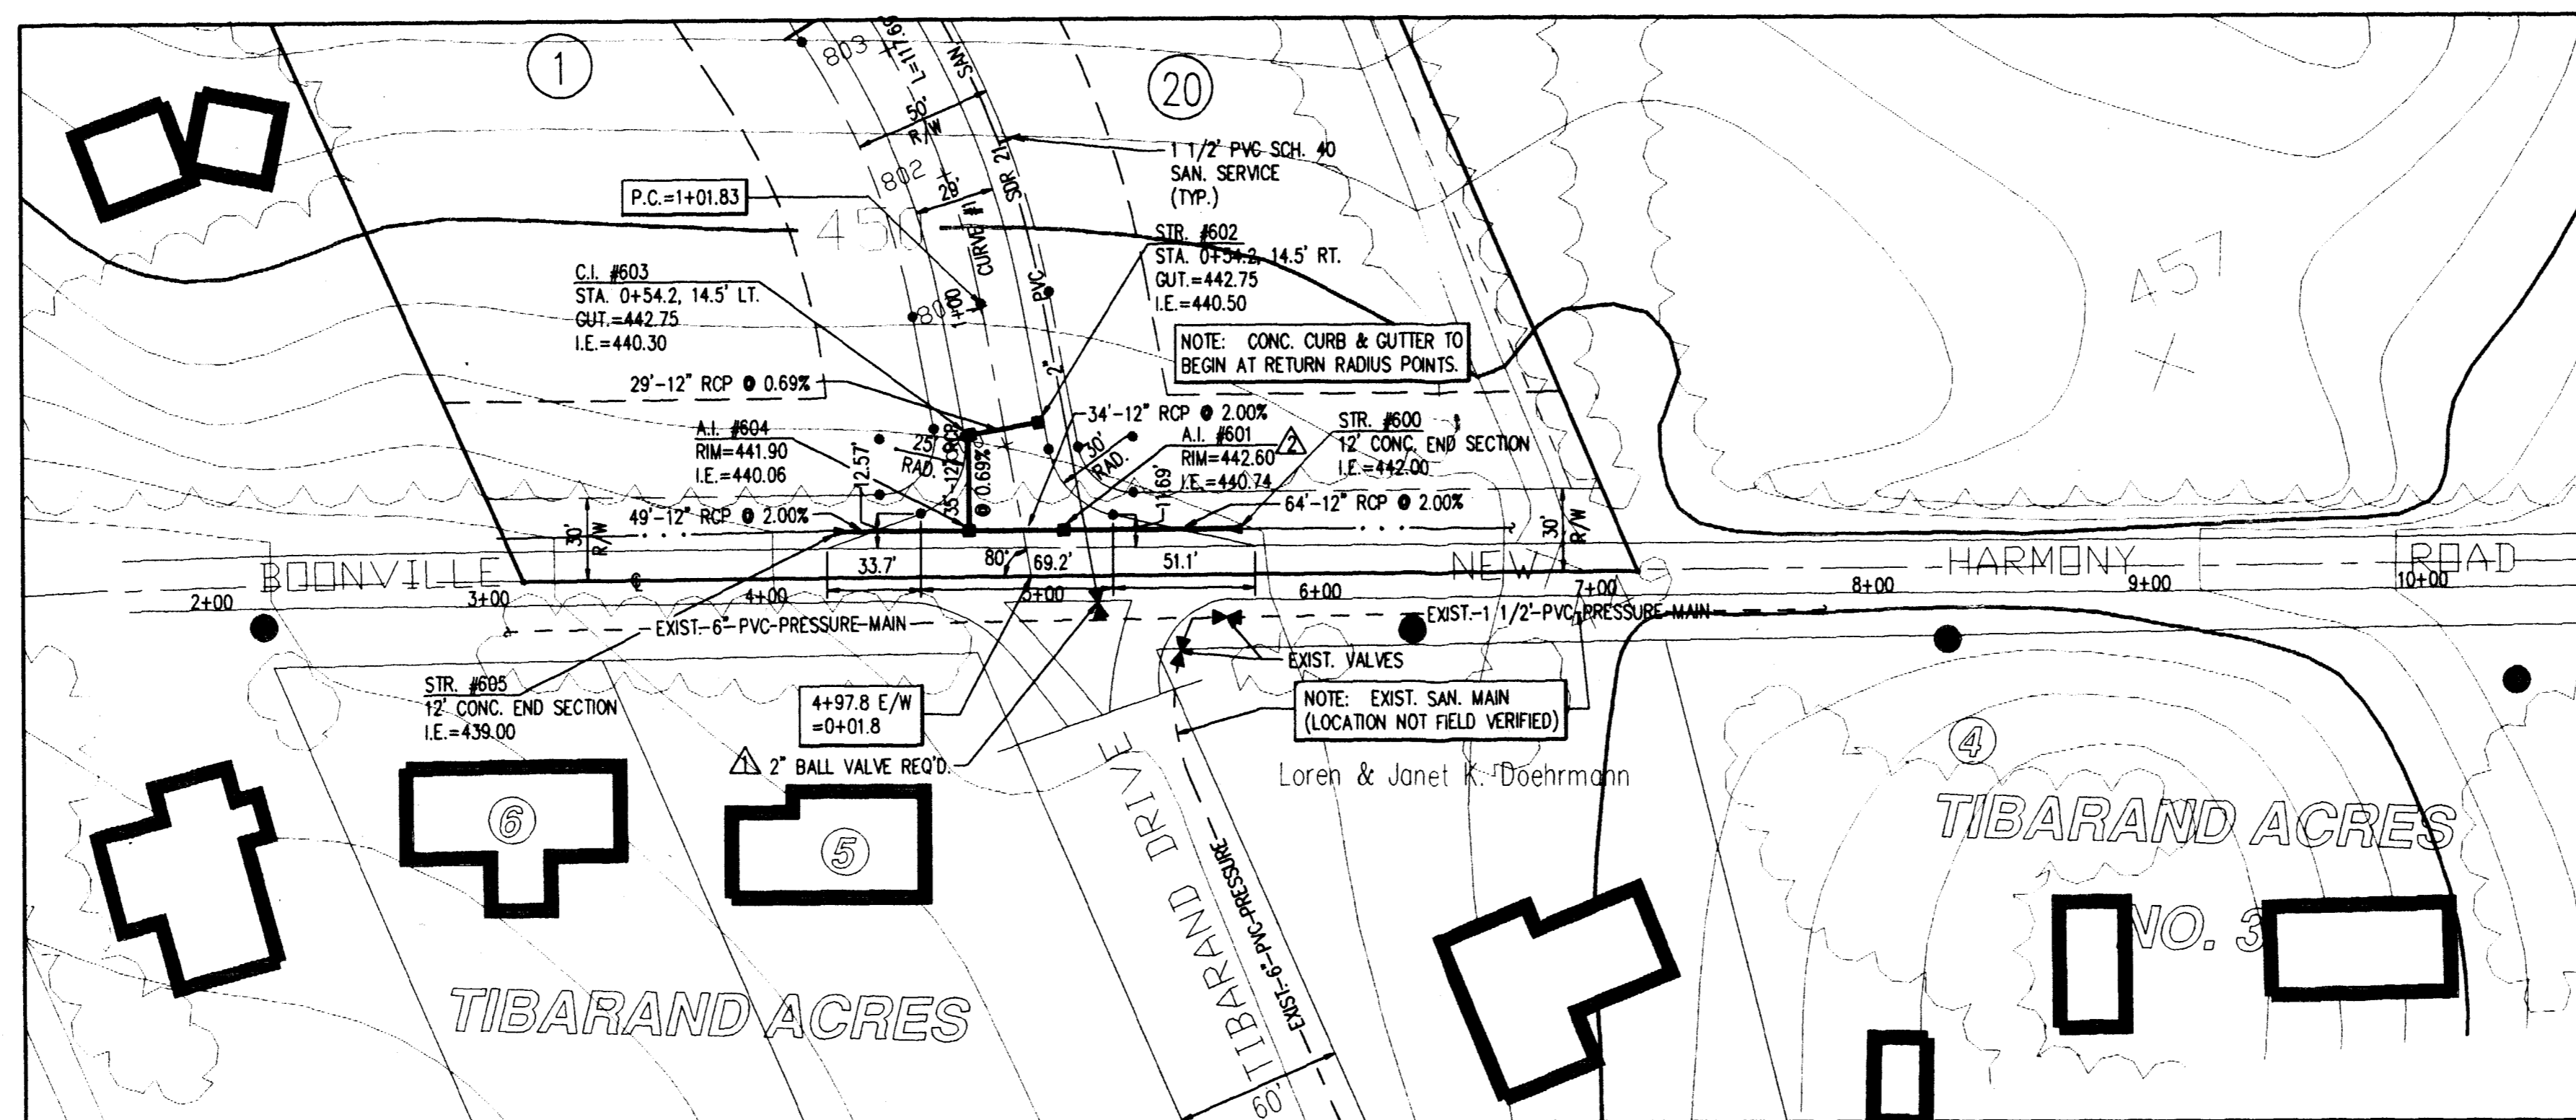


**ROAD CURVE DATA**

DESIGNATION	RADIUS	DELTA	LENGTH	CHORD	TANGENT
1	300.00'	22°28'40"	117.69'	N.02°09'05"E. 116.94'	59.61'

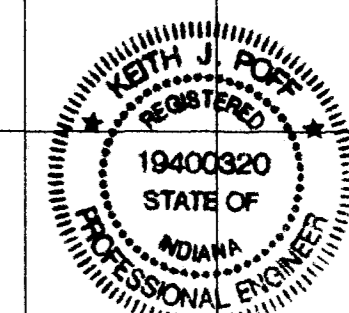

NOTE: ALL EXISTING TOPOGRAPHIC FEATURES AND CONTOURS WERE TAKEN FROM VANDERBURGH COUNTY TOPOGRAPHIC MAP #145 DATED MARCH 27, 1990.

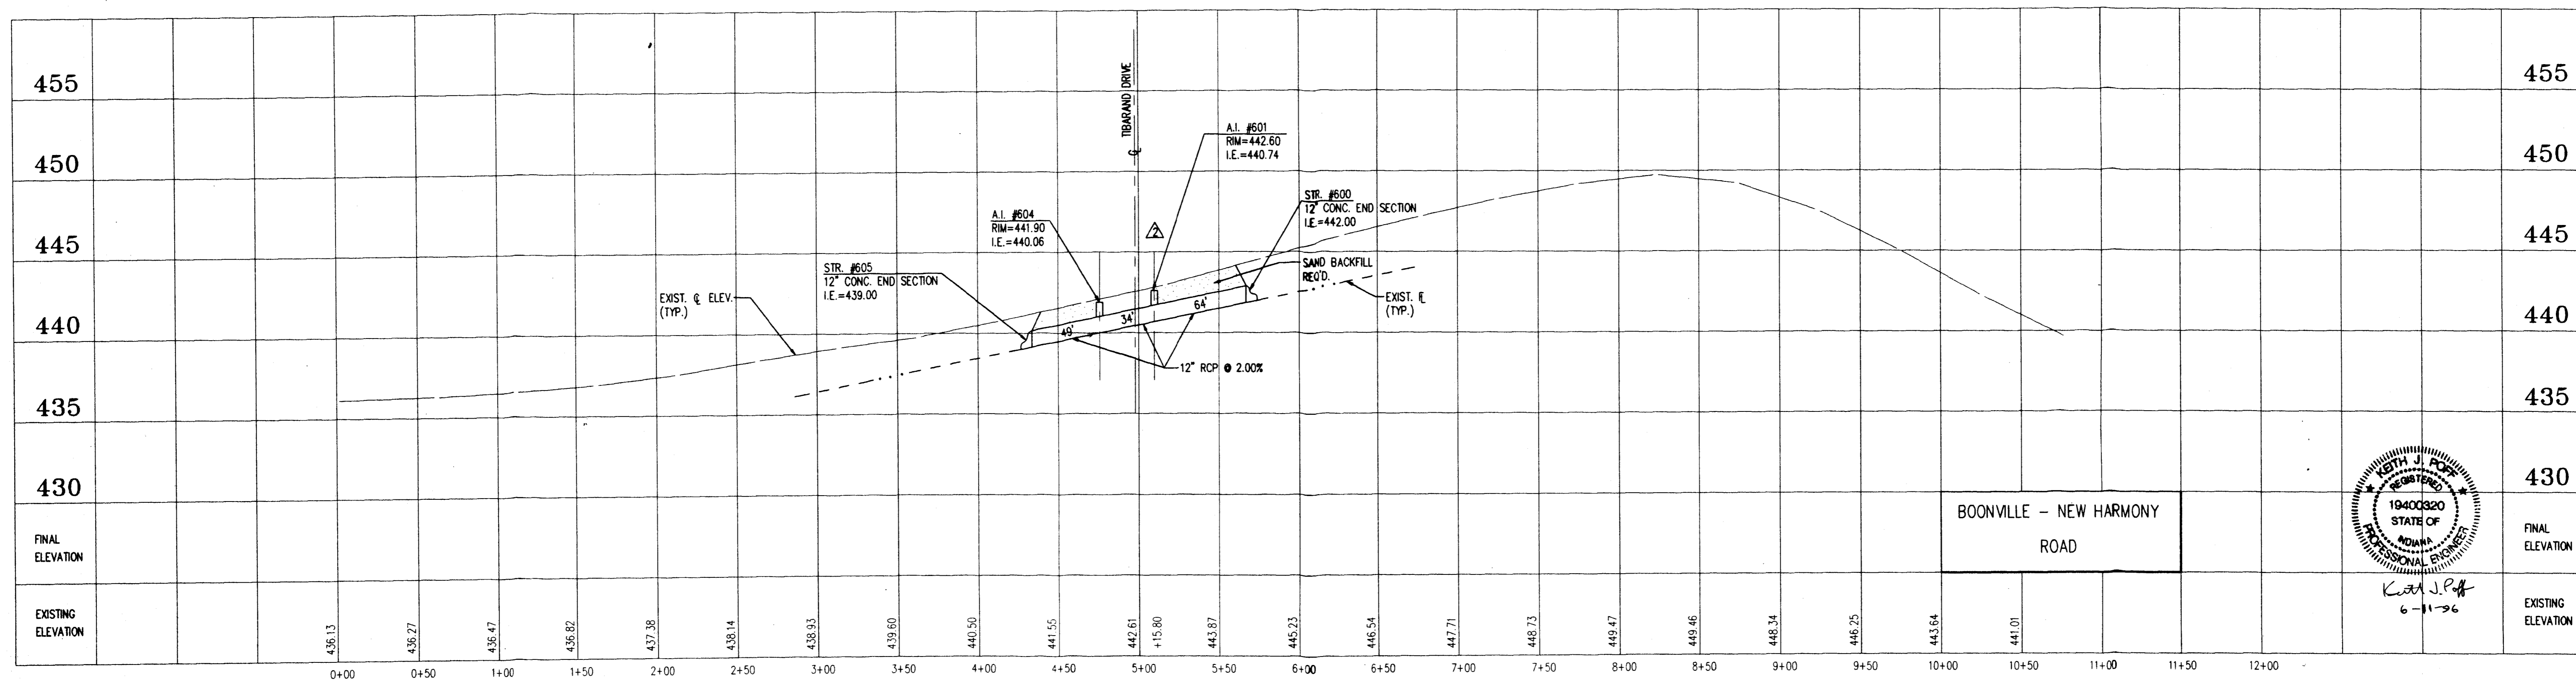

Keith J. Poff  
6-11-96