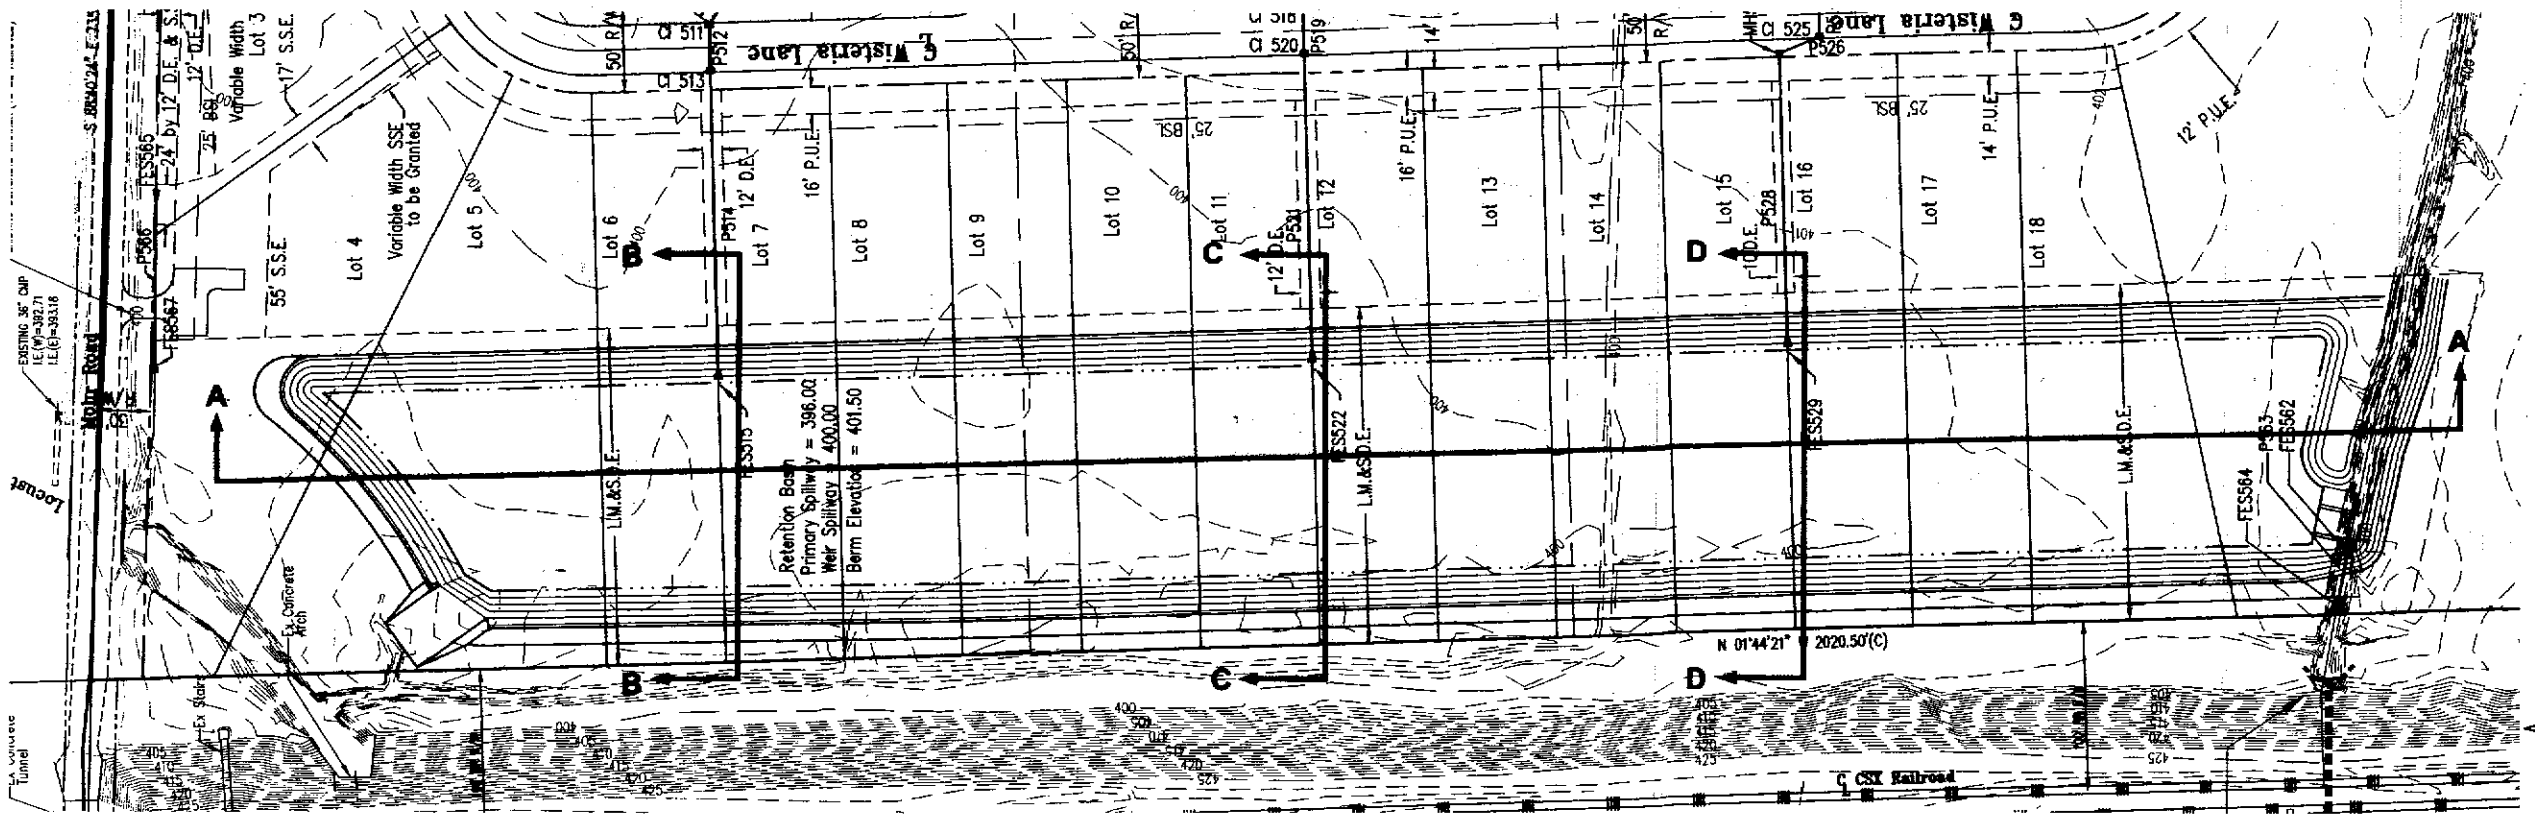

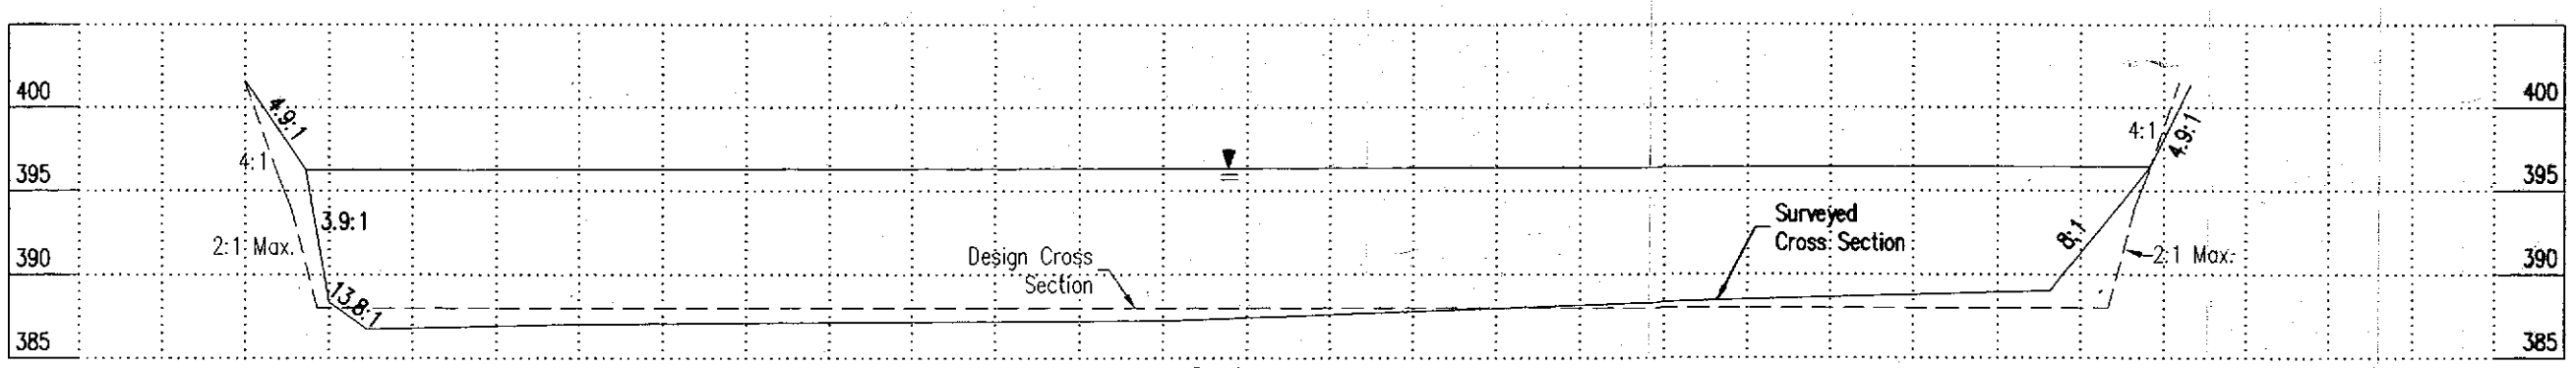

Cross Section A-A

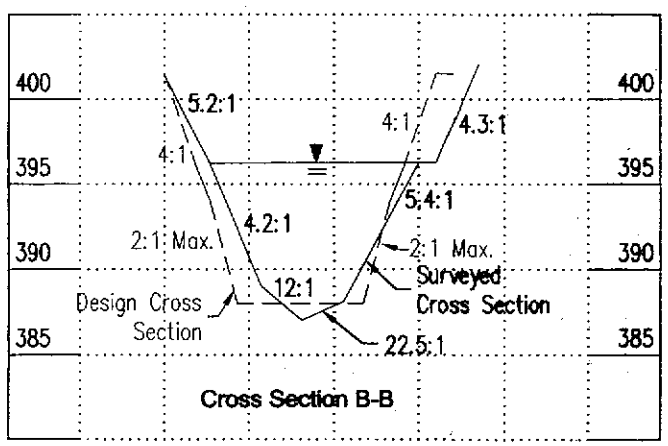

Cross Section B-B

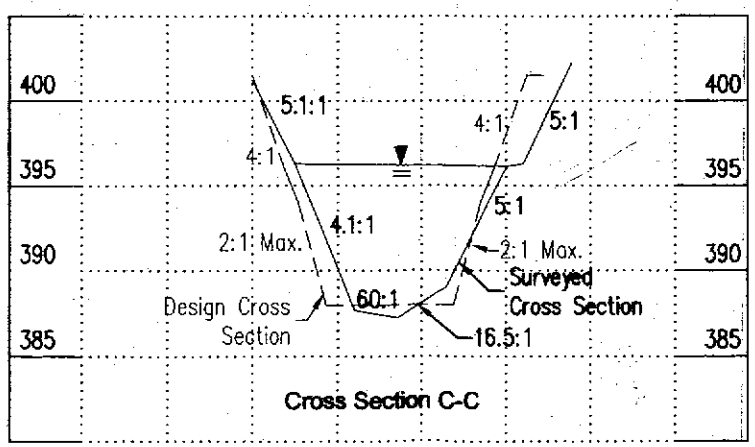

Cross Section C-C

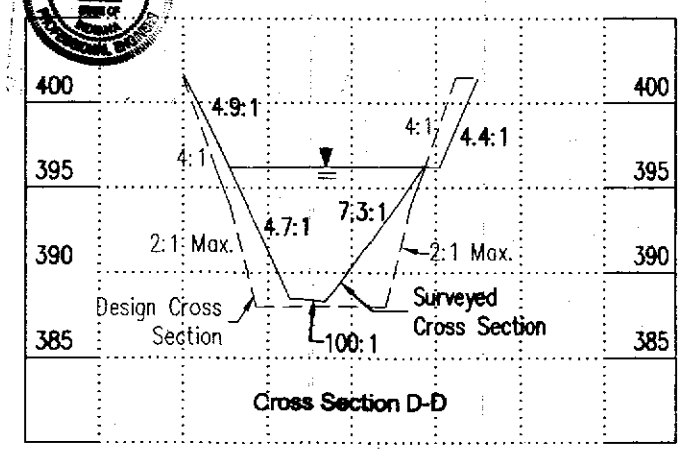

Cross Section D-D


Signature

PE 10100250

Indiana Registration Number

JAMES E. MORLEY REGISTERED No. 10100250 STATE OF INDIANA PROFESSIONAL ENGINEER 6-5-07

6-4-07

Engineering Surveying Architecture Construction Management

Morley and Associates Inc.

Evansville, In (812) 464-4480

Henderson, Ky (270) 830-0900

Jasper, In (812) 634-4900

www.morleyandassociates.com

All ideas, designs, arrangements and plans indicated or represented by this drawing are owned by and are the property of Morley and Associates, Inc. and were created, evolved and developed for use on and in connection with the construction of the project shown. Morley and Associates, Inc. shall not be liable for any damages, including consequential damages, for reuse of the drawings on any other project without the written permission of Morley and Associates, Inc. and without the written permission of Morley and Associates, Inc. shall be removed from all drawings prepared by it upon completion of the project. Any reuse without written permission or adaptation by Morley and Associates, Inc. for the specific purpose intended will be at the user's sole risk and without liability or legal exposure to Morley and Associates, Inc. and the user shall indemnify and hold harmless Morley and Associates, Inc. from all claims, damages, losses and expenses including attorney's fees arising out of or resulting therefrom. Any such verification or adaptation will entitle Morley and Associates, Inc. to further compensation at rates to be agreed upon by user and Morley and Associates, Inc.

Revisions

No.	By	Date	Description

Spring Lake Valley - Section 1
T. D. & T., LLC

RECORD Basin Cross Sections

Scale: 1" = 50' Horiz. 1" = 5' Vert.

Designed by: JEM | Job Number: 5553-4(B)

Drawn by: BSH | Date: 6/4/07

Project Phase

Sheet Number: Rec-1A

FILE = z:\5553\CAD\Va-Built\Section 1\Basin Xsect. RECORD.dwg PLOTTED 6/4/07 10:15 AM