



REVISED

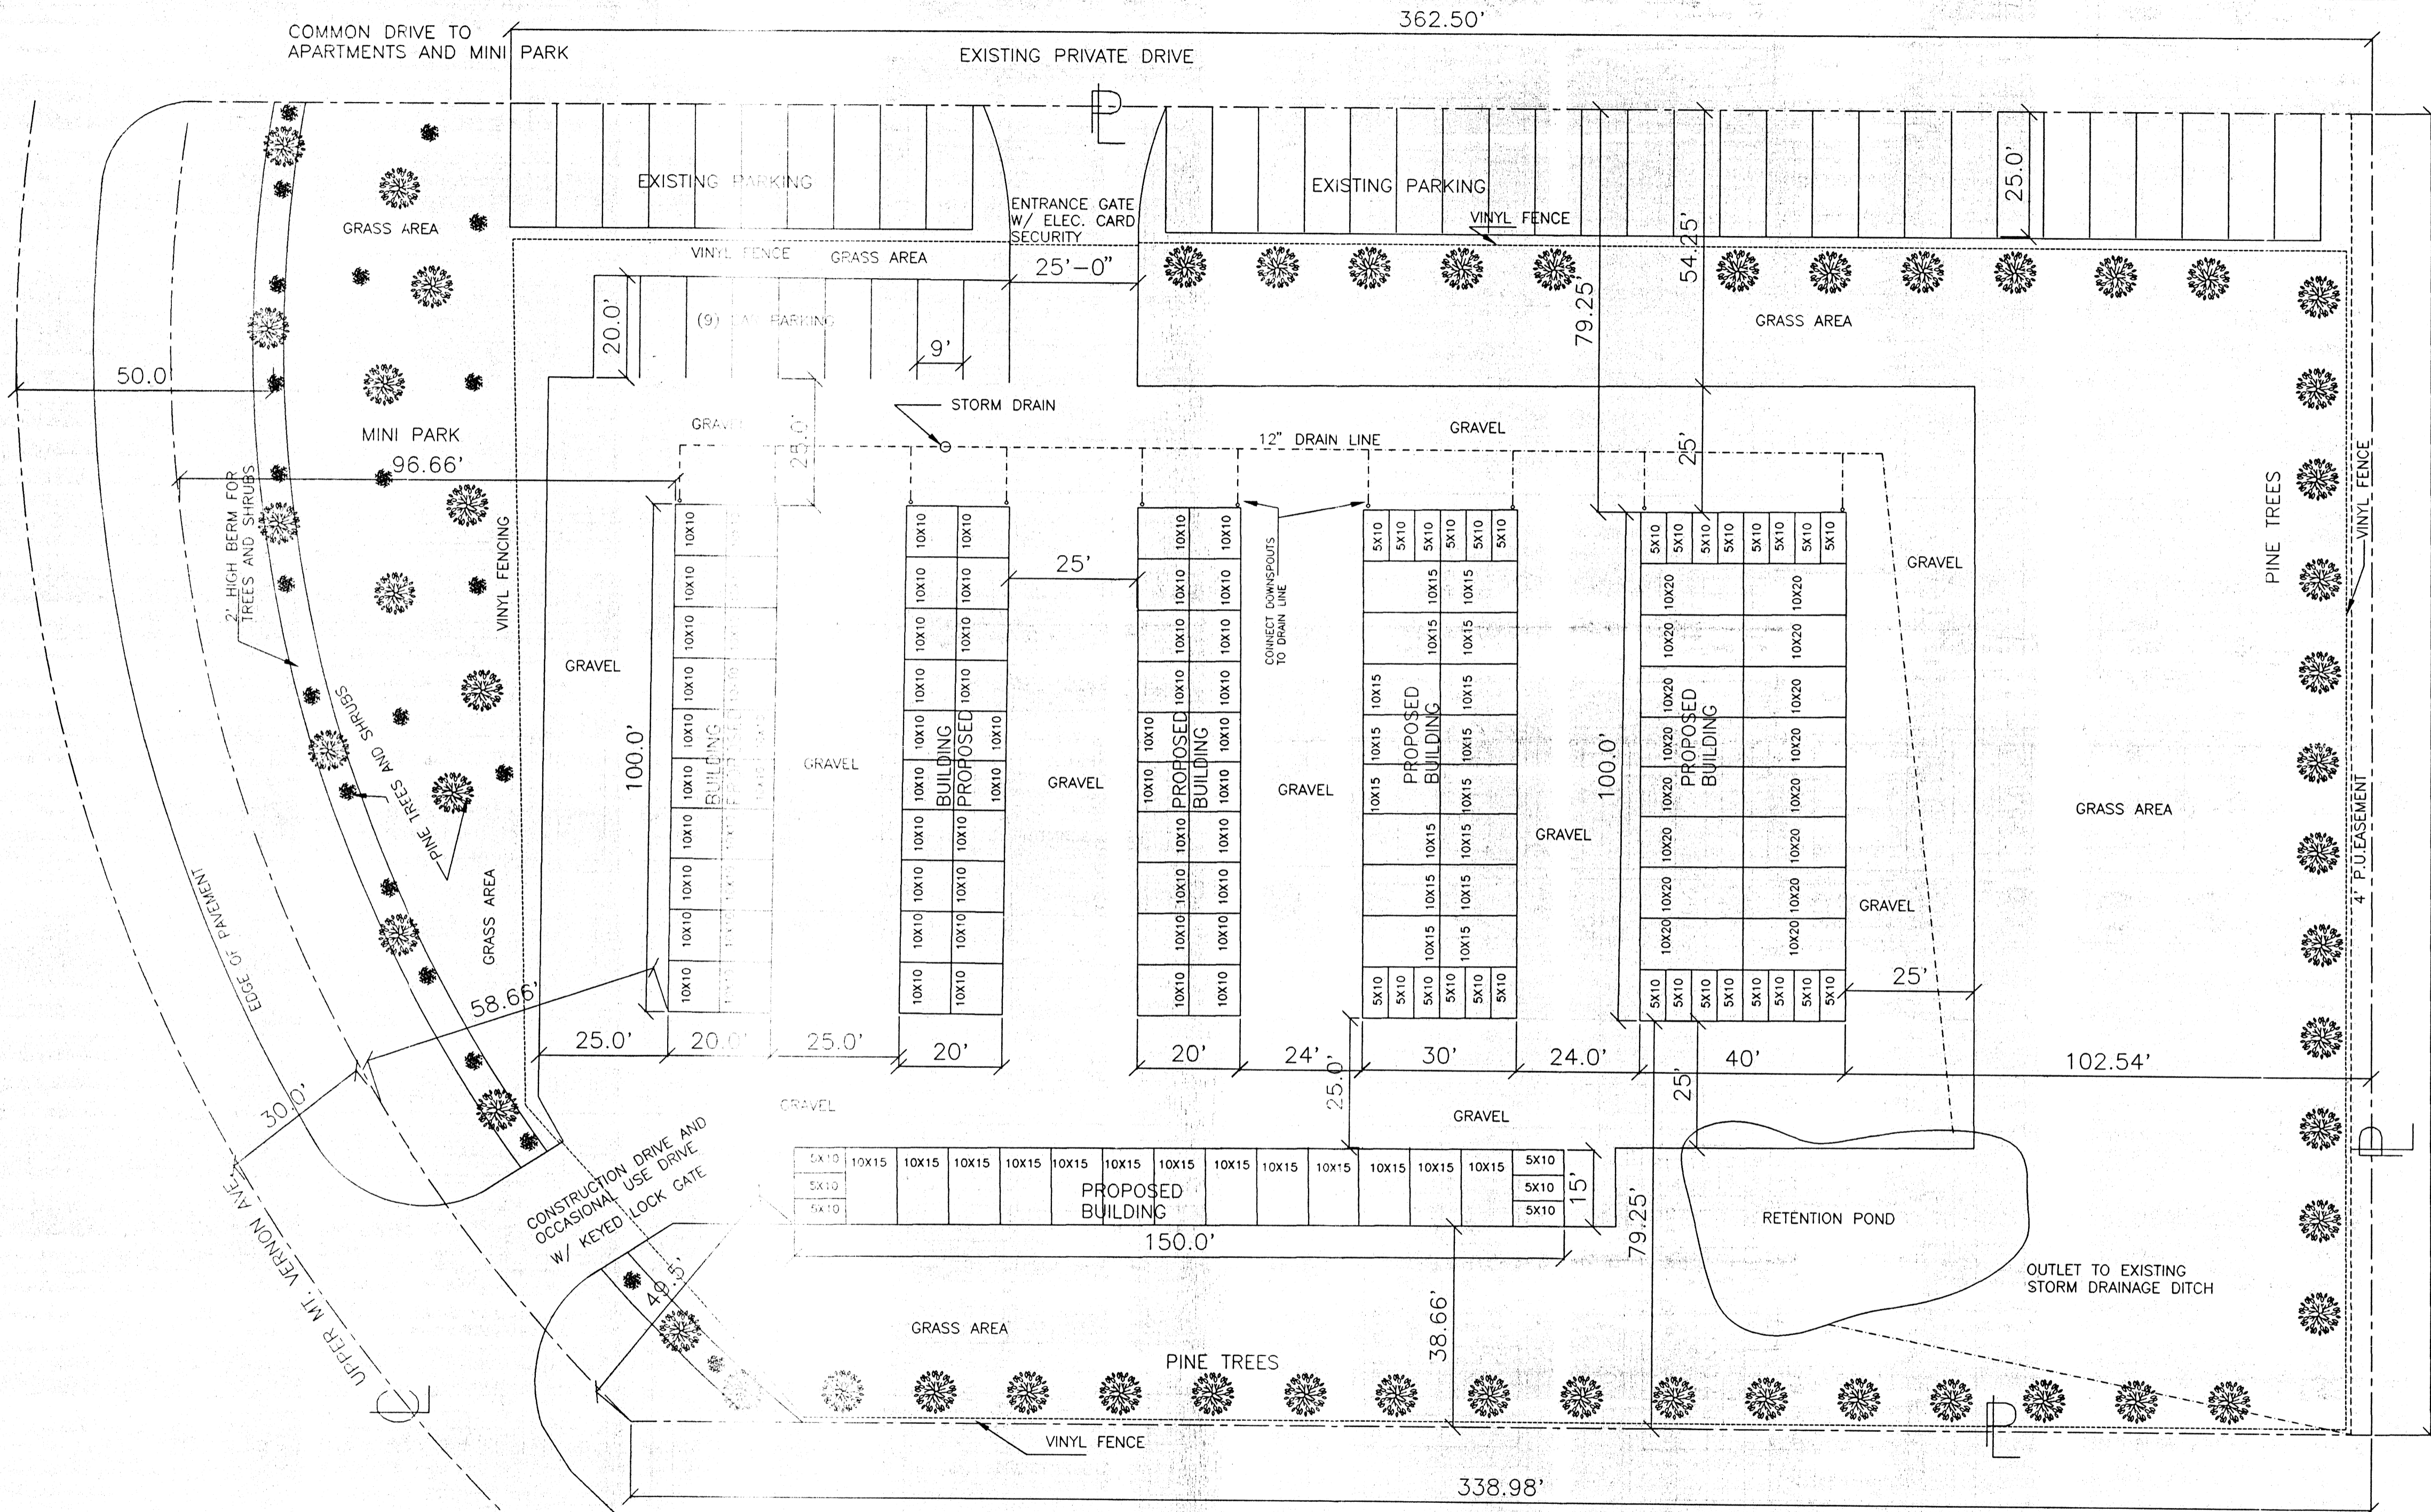

SITE REVIEW COMMITTEE 4-3-01
 APC *Richard [unclear]*
 DPV *[unclear]*
 EUTS *[unclear]*
 CITY ENGINEER *[unclear]*
 COUNTY ENGINEER *[unclear]*
 SUPPLEMENTARY REVIEW *[unclear]*
 BUILDING COMMISSIONER *[unclear]*
 SEWER AND WATER *[unclear]*

Gregory S. Whitmore

MT. VERNON AVE.
 SITE PLAN
 SCALE 1" = 20'-0"

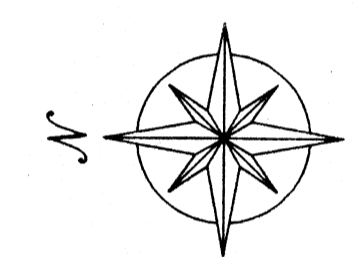

DESIGNER IS NOT AN ARCHITECT OR ENGINEER AND CONSTRUCTION FROM THESE PLANS SHOULD NOT BE UNDERTAKEN WITHOUT THE ASSISTANCE OF A CONSTRUCTION PROFESSIONAL. BECAUSE SITE CONDITIONS MAY VARY DESIGNER DOES NOT WARRANT THE SUITABILITY OF THESE PLANS FOR USE ON YOUR SPECIFIC SITE. CONSULT YOUR ARCHITECT TO DETERMINE THE SUITABILITY OF THESE PLANS FOR YOUR SPECIFIC SITE AND APPLICATION.

WEST PARK APARTMENTS

COMPLETE DESIGN SERVICE (812) 473-6433

SCALE 1"=20'-0"	CHECKED BY	DRAWN BY
DATE 1-21-00		B.W.SPAULDING
REVISED 10/17/00	REV 6/12/00 RBH	DRAWING NO.
	REV 9/17/00 RBH	RICKJOBE
	REV 03/26/01 BWS	